

Section 18 Township 18 Range 10W

Sec. 18 Twp. 18 R. 10W


Well No. #3 Hertach

Well No. #3 Hertach Farm _____


Company Murfin Drlg.

Murfin Drlg. Company _____

Murfin Contractor _____

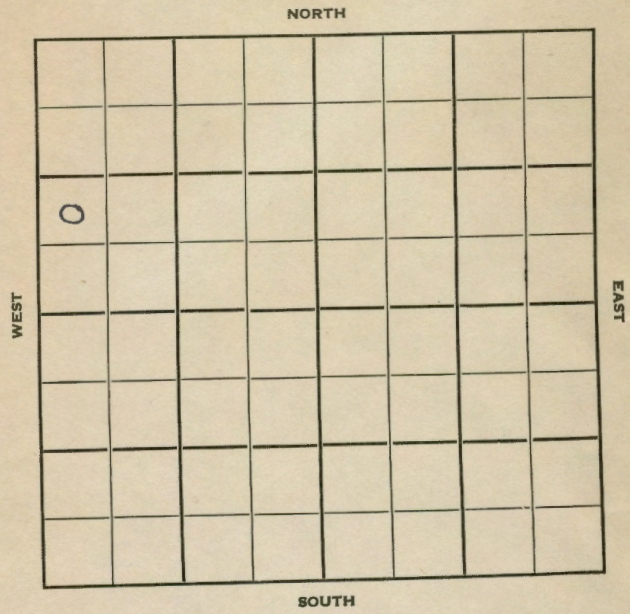

_____ Ft. from N. Line
990 Ft. from S. Line
 _____ Ft. from E. Line
330 Ft. from W. Line
NW SW NW

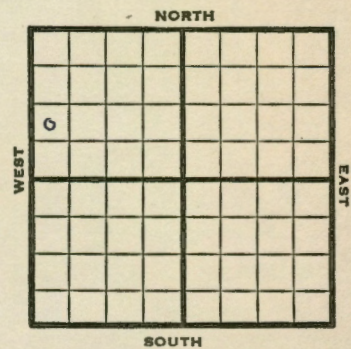

1952	Elev. 1773' REPORT
9/10	Spud 9-4-52 Drlg. 2430'
9/17	Heeb 2858' Lans. 2989' Arb. 3282' KX RTD 3285' 5" @ 3283'
9/24	Br Li 2970' B KC 3270' On Pump
10/1	NR
10/8	Spud 9-4-52 Oil Well TD 3286' Heeb. 2858 Lans. 2989 Arb. 3282 TD 3285 5" @ 3283 Br Li 2970 B KC 3270 TD 3286' Comp. 25 BOPD
COMPLETED	

County Rice State Kansas
Sec. 18 (Blk. 18) (Sur. 10W) (Twp.) (Rge.) Map No.

Operator Murfin Drlg.

Well No. 3 Farm Hertach

Elev. 1773 Location NW SW NW

990 Ft. From S Line NW

330 Ft. From W Line Quarter

lst. Report

Completion OCT 8 1952

Remarks

Murfin Drlg. - Contr.

Spudding Date 9-4-52

Drlg. Data Oil well TD 3286

Heeb. 2858 Lans. 2989 Arb. 3282

TD 3285 5" @ 3283 Br. lime 2970

B KC 3270 TD 3286 Comp. 25 bopd

J. G. McGEHEE

County Rice State Kansas
Sec. 18 (Blk. 18) (Sur. 10W) (Twp.) (Rge.) Map No.

Operator Murfin Drlg.

Well No. 3 Farm Hertach

Elev. Location NW SW NW

990 Ft. From S Line NW

330 Ft. From W Line Quarter

lst. Report SEP 10 1952

Completion

Remarks

Murfin - Contr.

Spudding Date 9-4-52

Drlg. Data

Drlg. 2430

J. G. McGEHEE