


**KANSAS**

Section 18 Township 18 Range 10W

Well No. #1 Marilyn Zink

Company Skelly Oil

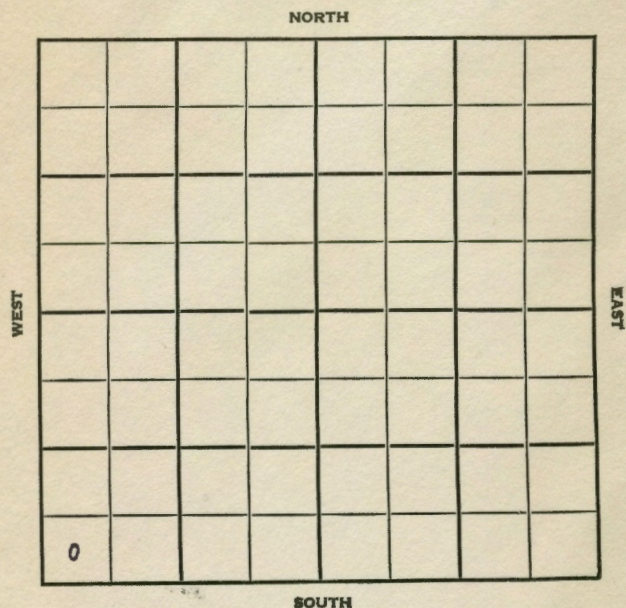

|                  |      |      |
|------------------|------|------|
| SEC.             | TWP. | R.   |
| 18               | 18   | 10 W |
| WELL NO.         |      |      |
| # 1 Marilyn Zink |      |      |
| COMPANY          |      | FARM |
| Skelly Oil       |      |      |
| CONTRACTOR       |      |      |

## Zink Pool


\_Ft. from N. Line

330 Ft. from S. Line

Ft. from E. Line

330 \_\_\_\_\_ Ft. from W. Line


SW SW SW

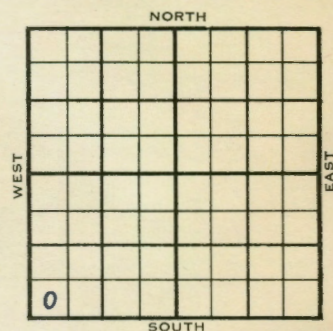

| ELEVATION |   | REPORT    |
|-----------|---|-----------|
| 1954      | 1772'   |           |
| 12/22     | Spud 12-19-54<br>8" @ 555' Anhy 544' WOC   |           |
| 1955      |   |           |
| 1/19      | Spud 12-19-54<br>Oil Well<br>TD 3278'<br>8" @ 555'<br>Anhy 544' Heeb 2850' Tor 2869'<br>Doug. 2883' Br. Lime 2962' Lans 2982'<br>DST 3057'-80' opn 1 hr, rec 60' o & gcm<br>60' mo 60' free oil 892" Arb. 3273'<br>TD 3277'<br>5" @ 3275'<br>DD 3278' FU 2100' oil 2½ hr. S/ 39 bo<br>4 hr. P/ 15 bo 1 hr. P/ 38 bo 6 hr.<br>Comp 591 bopd. | COMPLETED |

DX-78

County Rice State Kansas  
 Sec. 18 (Blk. 18 (Sur. 10W Map No.  
 Twp.) Rge.)  
 Operator Skelly Oil  
 Well No. 1 Farm Marilyn Zink  
 Elev. 1772 Location SW SW SW

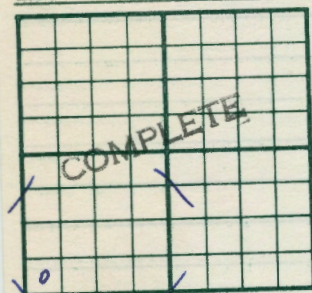

330 Ft. From S Line SW  
330 Ft. From W Line Quarter  
 1st. Report  
 Completion JAN 19 1955  
 Remarks Zink Pool  
 Spudding Date 12-19-54

Drig. Data Oil well TD 3278

8" @ 555 Anhy 544 Heeb. 2850

Tor. 2869 Doug. 2883 Br. lime 2962

Lans. 2982 DST 3057-80 open 1 hr.

Rec. 60' o & gcm 60' mo 60' free oil

892" Arb. 3273 TD 3277 5" @ 3275


DD 3278 FU 2100' oil 2 1/2 hr. S/ 39 bo

4 hr. P/ 15 bo 1 hr. P/ 38 bo 6 hr.

Comp. 591 bopd

FABEN GILSTRAP

County Rice State Kansas  
 Sec. 18 (Blk. 18 (Sur. 10W Map No.  
 Twp.) Rge.)  
 Operator Skelly Oil  
 Well No. 1 Farm Marilyn Zink  
 Elev. Location SW SW SW

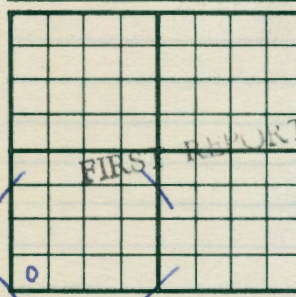

330 Ft. From S Line SW  
330 Ft. From W Line Quarter  
 1st. Report DEC 22 1954  
 Completion  
 Remarks  
 Spudding Date 12-19-54

Drig. Data Zink Pool

8" @ 555 Anhy 544 WOC

FABEN GILSTRAP