



Rice KANSAS

Section 19 Township 18 Range 10W
 Well No. 1 A. C. Zink
 Company Skelly Oil

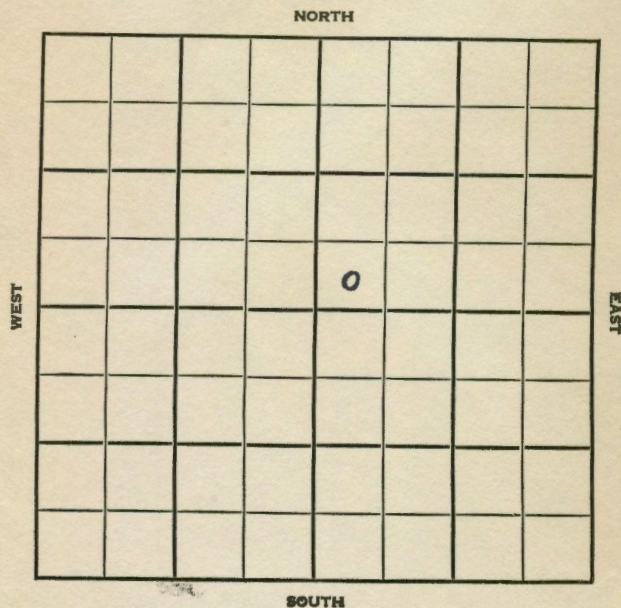

Rice KANSAS
 SEC. 19 TWP. 18 R. 10W ✓
 WELL NO. 1 A. C. Zink FARM
 COMPANY Skelly Oil
 CONTRACTOR

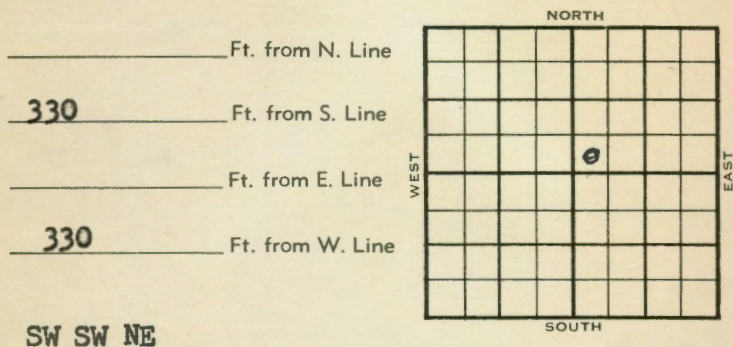

_____ Ft. from N. Line
330 _____ Ft. from S. Line
 _____ Ft. from E. Line
330 _____ Ft. from W. Line


SW SW NE

1954 ELEVATION
1760' REPORT

6/2 Location
 6/9 8" @ 542' **Anhy 537**
 Drlg. 2420'
 6/15 Spud 5-31-54
 D&A
 TD 3325'
Anhy 537'
 8" @ 542'
Top 2588', Heeb 2853', Tor 2870',
Doug. 2890'
 DST 2881-2955', opn 1 hr., rec. 15'
 mud, 630#
Lans 2987'
 DST 2990-3035', opn 1 hr., rec. 20' mud
 150#
Cong 3282', Arb. 3289'
 DST 3293-98', opn 1 hr., rec. 1' oil,
 36' vsocm, 1022#
 DST 3255-90', opn 1 hr., rec. 5' mud,
 39#
 DST 3298-3325', opn 1/2 hrs., rec. 1050'
 SW, 998#
 D&A

ABANDONED

County Rice State Kansas
 Sec. 19 (Blk. 18 (Sur. 10W Map No.
 (Twp. 18 (Rge. 10W
 Operator Skelly Oil
 Well No. 1 Farm A. C. Zink
 Elev. 1760 Location SW SW NE

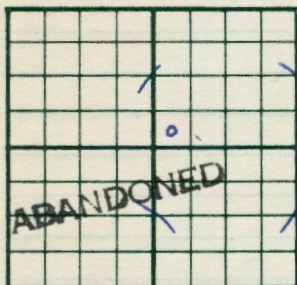

330 Ft. From S Line NE
 330 Ft. From W Line Quarter
 Ist. Report
 Completion JUN 15 1954
 Remarks

Spudding Date 5-31-54

Drlg. Data D & A TD 3325

Anhy 537 8" @ 542 Top. 2588

Heeb. 2853 Tor. 2870 Doug. 2890

DST 2881-2955 open 1 hr. Rec. 15' mud

630# Lans. 2987 DST 2990-3035

open 1 hr. Rec. 20' mud 150#

Cong. 3282 Arb: 3289 DST 3293-98

open 1 hr. Rec. 1' oil 36' vsocm

1022# DST 3255-90 open 1 hr. Rec.


5' mud 39# DST 3298-3325 open $\frac{1}{2}$ hr.

Rec. 1050' sw 998#

D. & A

J. G. McGEHEE

County Rice State Kansas
 Sec. 19 (Blk. 18 (Sur. 10W Map No.
 (Twp. 18 (Rge. 10W
 Operator Skelly Oil
 Well No. 1 Farm A. C. Zink
 Elev. Location SW SW NE

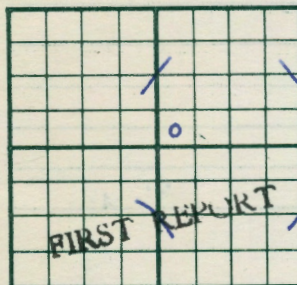

330 Ft. From S Line NE
 330 Ft. From W Line Quarter
 Ist. Report JUN 2 1954
 Completion
 Remarks

Spudding Date

Drlg. Data

Location

J. G. McGEHEE