

KANSAS
10W

18


18

Section _____ Township _____ Range _____

Well No. #4 Hertach

Company Murfin Drlg.

NORTH

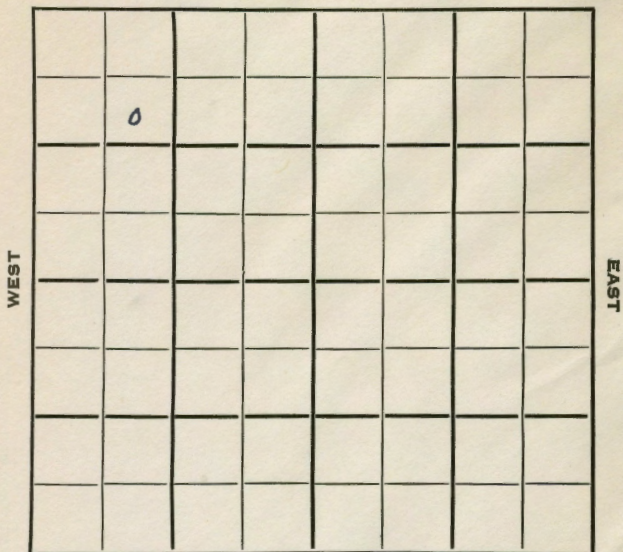

SOUTH

Rice KANSAS
18

10W

Sec. 18 Twp. 18 R. 10W

Well No. #4 Hertach Farm _____

Murfin Drlg. Company _____

Murfin Drlg. Contractor _____

990 Ft. from N. Line


_____ Ft. from S. Line

_____ Ft. from E. Line

990 Ft. from W. Line

SE NW NW

NORTH

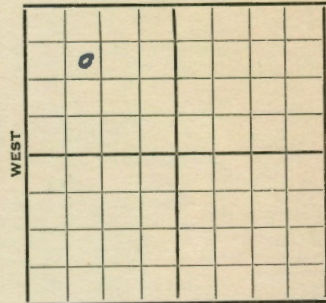

SOUTH

1953 Elev. 1775' REPORT

2/18 Spud 2-12-53
8" @ 208
Drlg. 2635'

2/26 Heeb 2859, Br 11 2973, Lans
2989, Cong 3304, Arb 3315
Drlg. 3735

3/12 RTD 3828' 5" @ 3345

3/19 NR

3/26 CO

4/2 "

4/9 NR

4/15 Spud 2-12-53
SWD Well
TD 3828
8" @ 208
Heeb 2859, Br line 2973, Lans 2989
Cong 3304, Arb. 3315,
TD 3828
5" @ 3345,
CO to 3828
Comp. for SWD WELL

ABANDONED

