
FORM CP-4

CORRECTED COPY

STATE OF KANSAS
STATE CORPORATION COMMISSION

WELL PLUGGING RECORD

Give All Information Completely
Make Required Affidavit
Mail or Deliver Report to
Conservation Division
State Corporation Comm.
245 North Water
Wichita, KS 67202

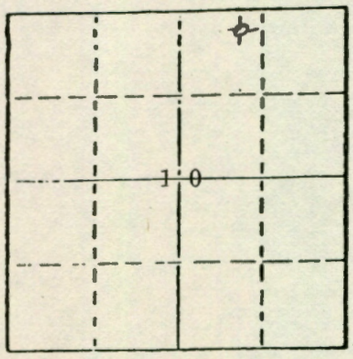

Locate well correctly on above Section Plat

Barton County. Sec. 10 Twp. 18S Rge. 11W E/W
Location as "NE/CNW¼SW¼" or footage from lines
NE NW NE
Lease Owner Rupe Oil Company
Lease Name Bieberle Well No. 1
Office Address P. O. Box 2273, 434 N. Ohio, Wichita, KS 672(
Character of Well (Completed as Oil, Gas or Dry Hole)
DRY HOLE
Date Well completed May 14, 1981
Application for plugging filed May 14, 1981
Application for plugging approved May 14, 1981
Plugging commenced May 14, 1981
Plugging completed May 14, 1981
Reason for abandonment of well or producing formation
DRY HOLE
If a producing well is abandoned, date of last production 19
Was permission obtained from the Conservation Division or its agents before plugging was commenced? YES

Name of Conservation Agent who supervised plugging of this well Maurice Leslie
Producing formation Depth to top Bottom Total Depth of Well 3,351'
Show depth and thickness of all water, oil and gas formations.

OIL, GAS OR WATER RECORDS — CASING RECORD

FORMATION	CONTENT	FROM	TO	SIZE	PUT IN	PULLED OUT
				8-5/8"	270'	

Describe in detail the manner in which the well was plugged, indicating where the mud fluid was placed and the method or methods used in introducing it into the hold. If cement or other plugs were used, state the character of same and depth placed, from feet to feet for each plug set.

Mud to 540', 60 sx cement
Mud to 260', 40 sx cement
Mud to 40', plug, 1/4 sack hulls
10 sx cement

(If additional description is necessary, use BACK of this sheet)
Name of Plugging Contractor

STATE OF Kansas COUNTY OF Sedgwick, ss.
Donald E. Hunt (employee of owner) or (~~xxxxxxxxxxxxxxxx~~)
of the above-described well, being first duly sworn on oath, says: That I have knowledge of the facts, statements, and matters herein contained and the log of the above-described well as filed and that the same are true and correct. So help me God.

(Signature) Donald E. Hunt
Suite 250, 200 West Douglas, Wichita, Kansas
(Address)

SUBSCRIBED AND SWORN TO before me this 20th day of May, 1981

KATHLEEN L. GREGER NOTARY PUBLIC STATE OF KANSAS

Kathleen L. Greger
Kathleen L. Greger Notary Public.

My commission expires January 20, 1985

"original" mailed to ... 6/29/81
& copy to ...