

KANSAS

WELL COMPLETION REPORT AND DRILLER'S LOG

State Geological Survey WICHITA BRANCH

S. 28 T.18S R. 13W NW
Loc. 100' NW of NE SW NW
County Barton

API No. 15 — Barton County — 009-22,319 Number

Operator
DOUBLE EAGLE EXPLORATION, INC.

Address
Suite 410, 100 S. Main, Wichita, KS 67202


Well No. #2 Lease Name Smith B

Footage Location
990 feet from South (N) line 990 feet from West (E) line

Principal Contractor Rains & Williamson Oil Co. Geologist Jay R. Dirks

Spud Date 3-30-81 Date Completed 4-8-81 Total Depth 3398' P.B.T.D.

Directional Deviation Oil and/or Gas Purchaser

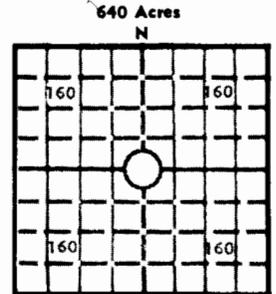

Locate well correctly
Elev.: Gr. 1868

DF KB 1873

CASING RECORD

Report of all strings set — surface, intermediate, production, etc.

Purpose of string	Size hole drilled	Size casing set (in O.D.)	Weight lbs/ft.	Setting depth	Type cement	Sacks	Type and percent additives
Surface	12 1/4"	8 5/8"	20#	788'	pozmix	425	60/40, 3%cc., 2%gel

LINER RECORD

PERFORATION RECORD

Top, ft.	Bottom, ft.	Sacks cement	Shots per ft.	Size & type	Depth interval

TUBING RECORD

Size	Setting depth	Packer set at

ACID, FRACTURE, SHOT, CEMENT SQUEEZE RECORD

Amount and kind of material used	Depth interval treated

INITIAL PRODUCTION

Date of first production		Producing method (flowing, pumping, gas lift, etc.)			
RATE OF PRODUCTION PER 24 HOURS		Oil bbls.	Gas MCF	Water bbls.	Gas-oil ratio CFPB
Disposition of gas (vented, used on lease or sold)				Producing interval (s)	

INSTRUCTIONS: As provided in KCC Rule 82-2-125, within 90 days after completion of a well, one completed copy of this Drillers Log shall be transmitted to the State Geological Survey of Kansas, 4150 Monroe Street, Wichita, Kansas 67209. Copies of this form are available from the Conservation Division, State Corporation Commission, 245 No. Water, Wichita, Kansas 67202. Phone AC 316-522-2206. If confidential custody is desired, please note Rule 82-2-125. Drillers Logs will be on open file in the Oil and Gas Division, State Geological Survey of Kansas, Lawrence, Kansas 66044.

Operator DOUBLE EAGLE EXPLORATION, INC.		DESIGNATE TYPE OF COMP.: OIL, GAS, DRY HOLE, SWDW, ETC.: Dry Hole
Well No. #2	Lease Name Smith B	
S 28 T 18S R 13 ^W ₄ E		


WELL LOG

Show all important zones of porosity and contents thereof; cored intervals, and all drill-stem tests, including depth interval tested, cushion used, time tool open, flowing and shut-in pressures, and recoveries.

SHOW GEOLOGICAL MARKERS, LOGS RUN, OR OTHER DESCRIPTIVE INFORMATION.

FORMATION DESCRIPTION, CONTENTS, ETC.	TOP	BOTTOM	NAME	DEPTH
Shale & Lime		2960		
Lime & Shale		3202		
Lime		3398		
Rotary Total Depth		3398		

USE ADDITIONAL SHEETS, IF NECESSARY, TO COMPLETE WELL RECORD.

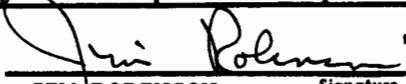Date Received	 Signature
	JIM ROBINSON President
	Title
	4-24-81 Date

956801