


Give All Information Completely
Make Required Affidavit
Mail or Deliver Report to:
Conservation Division
State Corporation Commission
800 Bittling Building
Wichita, Kansas

WELL PLUGGING RECORD

NORTH

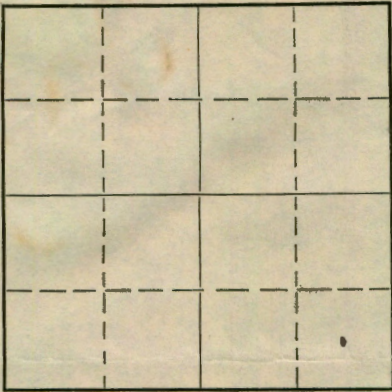

Locate well correctly on above
Section Plat

Barton County. Sec. 2 Twp. 18S Rge. 13 ~~12~~ (W)
Location as "NE/CNW $\frac{1}{4}$ SW $\frac{1}{4}$ " or footage from lines C SE SE SE $\frac{1}{4}$
Lease Owner Kantor Oil Company
Lease Name Eveleigh Well No. 1
Office Address Box 846 Tulsa, Oklahoma
Character of Well (completed as Oil, Gas or Dry Hole) Dry Hole
Date well completed February 9, 1951
Application for plugging filed February 9, 1951
Application for plugging approved February 9, 1951
Plugging commenced February 9, 1951
Plugging completed February 9, 1951
Reason for abandonment of well or producing formation.....

If a producing well is abandoned, date of last production.....19.....
Was permission obtained from the Conservation Division or its agents before plugging was commenced? Yes
C. D. Stough

Name of Conservation Agent who supervised plugging of this well.....
Producing formation..... Depth to top..... Bottom..... Total Depth of Well.....3356 Feet
Show depth and thickness of all water, oil and gas formations.

OIL, GAS OR WATER RECORDS

CASING RECORD

Formation	Content	From	To	Size	Put In	Pulled Out
		<u>0</u>	<u>518'</u>	<u>8 5/8"</u>	<u>518'</u>	<u>None</u>

Describe in detail the manner in which the well was plugged, indicating where the mud fluid was placed and the method or methods used in introducing it into the hole. If cement or other plugs were used, state the character of same and depth placed, from.....feet to.....feet for each plug set.

Filled with heavy mud thru drill pipe to 270'.
Set bottom plug at 270'.
Cemented to top thru drill pipe with 15 sacks.
Set plug at 30'.
Dumped ten sacks cement to bottom cellar.

(If additional description is necessary, use BACK of this sheet)

Correspondence regarding this well should be addressed to Kantor Oil Company
Address Box 846 Tulsa, Oklahoma

STATE OF Kansas COUNTY OF Tulsa, ss.
Kantor (employee of owner) or (owner or operator) of the above-described well,
being first duly sworn on oath, says: That I have knowledge of the facts, statements, and matters herein contained and the log of the above-described well as filed and that the same are true and correct. So help me God.

(Signature) Kantor

(Address) Tulsa, Oklahoma

SUBSCRIBED AND SWORN to before me this 14 day of Feb., 1951

My commission expires 1-14-52

Notary Public.