

19-18-17W<sup>And</sup>

STATE CORPORATION COMMISSION OF KANSAS  
OIL & GAS CONSERVATION DIVISION  
WELL COMPLETION OR RECOMPLETION FORM  
ACO-1 WELL HISTORY  
DESCRIPTION OF WELL AND LEASE

Operator: License # 5140  
Name ... Frontier Oil Company  
Address ... 125 N. Market, Ste. 1720  
City/State/Zip ... Wichita, Kansas 67202

Purchaser ... N/A

Operator Contact Person ... Jean Angle  
Phone ... 316-263-1201

Contractor: License # 5302  
Name ... Red Tiger Drilling Co.

Wellsite Geologist ... Richard D. Parker  
Phone ... 913-483-5348

## Designate Type of Completion

☒ New Well ☐ Re-Entry ☐ Workover  
  
☐ Oil ☒ SWD ☐ Temp Abd  
☐ Gas ☐ Inj ☐ Delayed Comp  
☐ Dry ☐ Other (Core, Water Supply etc.)

If ~~OWNO~~: old well info as follows:

Operator .....  
Well Name .....  
Comp. Date ..... Old Total Depth.....

## WELL HISTORY

Drilling Method:

☒ Mud Rotary ☐ Air Rotary ☐ Cable

.4-7-89.... .4-18-89.... 5-05-89  
Spud Date Date Reached TD Completion Date  
4100 N/A  
Total Depth PBTD

Amount of Surface Pipe Set and Cemented at 1007 feet  
Multiple Stage Cementing Collar Used? ☐ Yes ☒ No  
If yes, show depth set.....feet  
If alternate 2 completion, cement circulated  
from.....feet depth to.....w/.....SX cmt  
Cement Company Name .....  
Invoice # .....

API NO. 15-... 165-21-468

County..... Rush

SW.NE.SW ..... Sec. 19 Twp. 18 Rge. 17W ☒ East  
West

1650.... Ft North from Southeast Corner of Section

3630.... Ft West from Southeast Corner of Section

(Note: Locate well in section plat below)


Lease Name..... Seuser Well #..... 6...

Field Name..... Rudi SE

Producing Formation..... N/A

Elevation: Ground..... 1981 KB..... 1986

## Section Plat

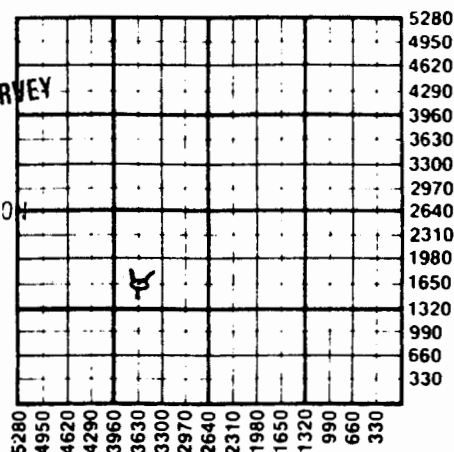

KANSAS GEOLOGICAL SURVEY  
WICHITA BRANCH  
RECEIVED  
STATE CORPORATION COMMISSION

MAY 16 1989

MAY 18 1989

## WATER SUPPLY INFORMATION

Disposition of Produced Water: ☐ Disposal  
Docket # ..... ☐ Repressuring

## Questions on this portion of the ACO-1 call:

Water Resources Board (913) 296-3717

Source of Water: Mr. Lester Seuser, Tinker, KS

Division of Water Resources Permit #... Unknown

☒ Groundwater 1400 Ft North from Southeast Corner  
(Well) 4500 Ft West from Southeast Corner of  
Sec 19 Twp 18 Rge ~~XXXXXX~~ 17 West

Surface Water.....Ft North from Southeast Corner  
(Stream, pond etc).....Ft West from Southeast Corner  
Sec Twp Rge ☐ East ☐ West

Other (explain).....  
(purchased from city, R.W.D. #)

INSTRUCTIONS: This form shall be completed in triplicate and filed with the Kansas Corporation Commission, 200 Colorado Derby Building, Wichita, Kansas 67202, within 120 days of the spud date of any well. Rule 82-3-130, 82-3-107 and 82-3-106 apply.  
Information on side two of this form will be held confidential for a period of 12 months if requested in writing and submitted with the form. See rule 82-3-107 for confidentiality in excess of 12 months.  
One copy of all wireline logs and drillers time log shall be attached with this form. Submit CP-4 form with all plugged wells. Submit CP-111 form with all temporarily abandoned wells.