

2-185-2W

OFFICE OF COUNTY ENGINEER

OWLL

McPherson, Kansas

To: Dorset
DAREST Co.
610 NATIONAL BANK
TULSA BUILDING
TULSA, OKLAHOMA

Date FEB. 14-1966

Name of Lease _____

Att:

Well No. LINDBERG # 1

Gentlemen:

County McPHERSON, KANSAS

Confirming your request by TELEPHONE


we wish to advise that the above location was staked 2-15-66, 19 66

Section 2

Twp. 18 S.

Range 2 W.

GROUND ELEV. 1445.2'

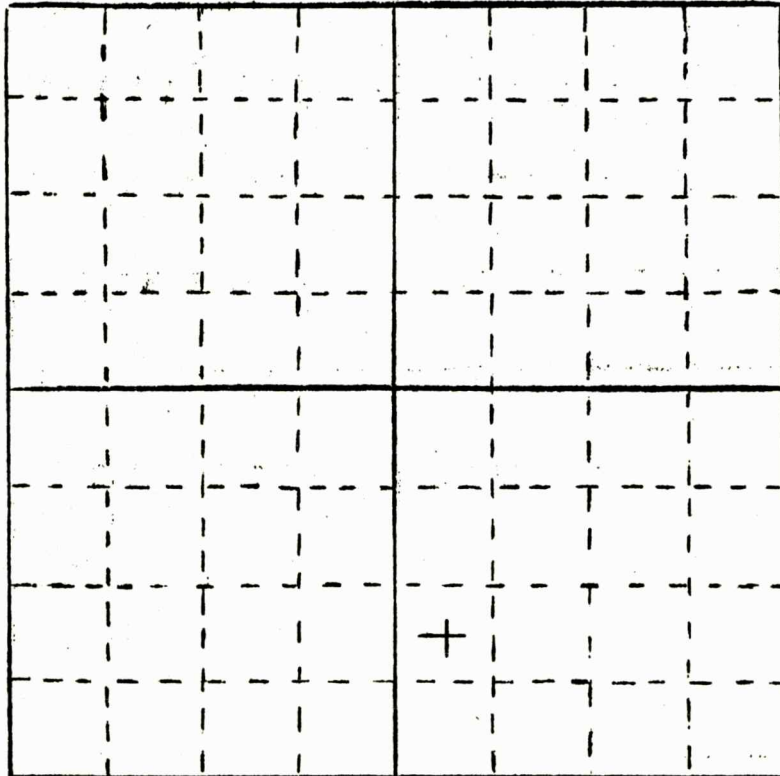

1650'

330'

I, FRANCIS RANKIN, COUNTY ENGINEER, do hereby certify that I have placed, caused to be placed location stake for the above named well at the following described location: NW1/4, SW1/4, SE1/4 SEC 2 T18S- R2W

as shown on the above named PLAT.

Feb 16, 1966
Date

Francis Rankin
Signature

OWLL