

SIDE ONE

STATE CORPORATION COMMISSION OF KANSAS
OIL & GAS CONSERVATION DIVISION
WELL COMPLETION FORM
ACO-1 WELL HISTORY
DESCRIPTION OF WELL AND LEASE

Operator: License # 30269Name: Argent Energy, Inc.Address 110 South Main, Suite 510City/State/Zip Wichita, KS 67202

Purchaser: _____

Operator Contact Person: James C. RemsbergPhone (316) 262-5111Contractor: Name: Murfin Drilling Co.License: 30606Wellsite Geologist: Scott A. Oatsdean

Designate Type of Completion

☐ New Well ☐ Re-Entry ☐ Workover
☐ Oil ☐ SWD ☐ Temp. Abd.
☐ Gas ☐ Inj ☐ Delayed Comp.
☒ Dry ☐ Other (Core, Water Supply, etc.)

If OWM: old well info as follows:

Operator: _____

Well Name: _____

Comp. Date _____ Old Total Depth _____

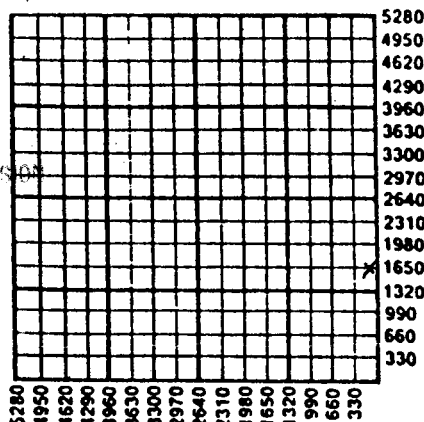
Drilling Method:

☒ Mud Rotary ☐ Air Rotary ☐ Cable9/16/91 9/22/91 9-22-91

Spud Date Date Reached TD Completion Date

API NO. 15- 135-23.604County NessSE NE SE Sec. 25 Twp. 18S Rge. 24 ☒ East West1650 Ft. North from Southeast Corner of Section90 Ft. West from Southeast Corner of Section
(NOTE: Locate well in section plat below.)Lease Name Maier-Ness City Well # 1Field Name Unnamed

Producing Formation _____

Elevation: Ground 2245' KB 2250'Total Depth 4300' PBTD _____Amount of Surface Pipe Set and Cemented at 801 FeetMultiple Stage Cementing Collar Used? ☐ Yes ☒ No

If yes, show depth set _____ Feet

If Alternate II completion, cement circulated from _____

feet depth to _____ w/ _____ sx cmt.

INSTRUCTIONS: This form shall be completed in triplicate and filed with the Kansas Corporation Commission, 200 Colorado Derby Building, Wichita, Kansas 67202, within 120 days of the spud date of any well. Rule 82-3-130, 82-3-107 and 82-3-106 apply. Information on side two of this form will be held confidential for a period of 12 months if requested in writing and submitted with the form. See rule 82-3-107 for confidentiality in excess of 12 months. One copy of all wireline logs and drillers time log shall be attached with this form. ALL CEMENTING TICKETS MUST BE ATTACHED. Submit CP-4 form with all plugged wells. Submit CP-111 form with all temporarily abandoned wells. Any recompletion, workover or conversion of a well requires filing of ACO-2 within 120 days from commencement date of such work.

All requirements of the statutes, rules and regulations promulgated to regulate the oil and gas industry have been fully complied with and the statements herein are complete and correct to the best of my knowledge.

Signature James C. RemsbergTitle James C. Remsberg, President Date 10/11/91scribed and sworn to before me this 11th day of October, 91.Notary Public Julie O. KokerDate Commission Expires December 4, 1993

JULIE O. KOKER
NOTARY PUBLIC
STATE OF KANSAS

K.C.C. OFFICE USE ONLY

F ☐ Letter of Confidentiality Attached
C ☐ Wireline Log Received
C ☒ Drillers Timelog Received

Distribution

☒ KCC ☐ SWD/Rep ☐ NGPA
☒ KGS ☐ Plug ☒ Other
(Specify)

25281

SIDE TWO

Operator Name Argent Energy, Inc. Lease Name Maier-Ness City Well # 1
 Sec. 25 Twp. 18S Rge. 24 ☐ East ☒ West
 County Ness

INSTRUCTIONS: Show important tops and base of formations penetrated. Detail all cores. Report all drill stem tests giving interval tested, time tool open and closed, flowing and shut-in pressures, whether shut-in pressure reached static level, hydrostatic pressures, bottom hole temperature, fluid recovery, and flow rates if gas to surface during test. Attach extra sheet if more space is needed. Attach copy of log.

Drill Stem Tests Taken ☐ Yes ☒ No
 (Attach Additional Sheets.)

Samples Sent to Geological Survey ☐ Yes ☒ No

Cores Taken ☐ Yes ☒ No

Electric Log Run ☐ Yes ☒ No
 (Submit Copy.)

Formation Description

☐ Log ☒ Sample

| Name | Top | Bottom |
|---------------|-------|----------|
| Heebner | 3634' | (-1384') |
| Lansing | 3626' | (-1426') |
| B/K.C. | 3973' | (-1723') |
| Marmaton | 4000' | (-1750') |
| Ft. Scott | 4175' | (-1925') |
| Mississippian | 4295' | (-2045') |

CASING RECORD

☐ New ☒ Used

Report all strings set-conductor, surface, intermediate, production, etc.

| Purpose of String | Size Hole Drilled | Size Casing Set (In O.D.) | Weight Lbs./ft. | Setting Depth | Type of Cement | # Sacks Used | Type and Percent Additives |
|-------------------|-------------------|---------------------------|-----------------|---------------|------------------|--------------|----------------------------|
| Surface | 12 1/4" | 8-5/8" | 25# | 801' | 60/40 poz MTX | 315 | 2% gel 3% cc |
| | | | | | | | |
| | | | | | | | |
| | | | | | | | |

PERFORATION RECORD

Shots Per Foot Specify Footage of Each Interval Perforated

Acid, Fracture, Shot, Cement Squeeze Record
 (Amount and Kind of Material Used) Depth

| | | | | | | | |
|--|--|--|--|--|--|--|--|
| | | | | | | | |
| | | | | | | | |
TUBING RECORD

Size Set At Packer At

Liner Run ☐ Yes ☐ No

Date of First Production Producing Method ☐ Flowing ☐ Pumping ☐ Gas Lift ☐ Other (Explain)

| Estimated Production Per 24 Hours | Oil Bbls. | Gas Mcf | Water Bbls. | Gas-Oil Ratio | Gravity |
|-----------------------------------|-----------|---------|-------------|---------------|---------|
| | | | | | |

Disposition of Gas:

☐ Vented ☐ Sold ☐ Used on Lease
 (If vented, submit ACO-18.)

METHOD OF COMPLETION

☐ Open Hole ☐ Perforation ☐ Dually Completed ☐ Commingled
☐ Other (Specify) _____

Production Interval