

KANSAS DRILLERS LOG

IMPORTANT
Kans. Geo. Survey request
samples on this well.

API No. 15 — 113 — 20,599
County Number

Operator

Excalibur Production Company, Inc.

Address

Box 278 McPherson, Kansas 67460

Well No.

#1

Lease Name

Sven Burk

Footage Location

330 feet from (N) (S) line 330 feet from (E) (W) line

Principal Contractor

Blackstone Drilling, Inc.

Geologist

Donald J. Melland

Spud Date

November 11, 1978

Total Depth

3683

P.B.T.D.

Date Completed

November 19, 1978

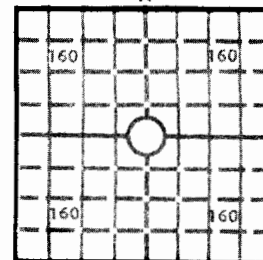
Oil Purchaser

Dry

S. 35 T. 18 R. 3 E W

Loc. NW NW NW

County McPherson

640 Acres
N

Locate well correctly

Elev.: Gr. 1523

DF 1525 KB 1527

CASING RECORD

Report of all strings set — surface, intermediate, production, etc.

Purpose of string	Size hole drilled	Size casing set (in O.D.)	Weight lbs/ft.	Setting depth	Type cement	Sacks	Type and percent additives
Surface	11"	8 5/8	28	153	common	100	

LINER RECORD

PERFORATION RECORD

Top, ft.	Bottom, ft.	Sacks cement	Shots per ft.	Size & type	Depth interval

Size	Setting depth	Packer set at			

ACID, FRACTURE, SHOT, CEMENT SQUEEZE RECORD

Amount and kind of material used	Depth interval treated

INITIAL PRODUCTION

Date of first production

Producing method (flowing, pumping, gas lift, etc.)

RATE OF PRODUCTION
PER 24 HOURS

Oil

bbls.

Gas

MCF

Water

Gas-oil ratio

bbls.

CFPB

Disposition of gas (vented, used on lease or sold)

Producing interval(s)

INSTRUCTIONS: As provided in KCC Rule 82-2-125, within 90 days after completion of a well, one completed copy of this Drillers Log shall be transmitted to the State Geological Survey of Kansas, 4150 Monroe Street, Wichita, Kansas 67209. Copies of this form are available from the Conservation Division, State Corporation Commission, 3830 So. Meridian (P.O. Box 17027), Wichita, Kansas 66217. Phone AC 316-522-2206. If confidential custody is desired, please note Rule 82-2-125. Drillers Logs will be on open file in the Oil and Gas Division, State Geological Survey of Kansas, Lawrence, Kansas 66044.

Operator Excalibur Production Co., Inc.		DESIGNATE TYPE OF COMP.: OIL, GAS, DRY HOLE, SWDW, ETC.: D & A
Well No. 1	Lease Name Swen Burk	
S 35 T 18 R 3 K W		

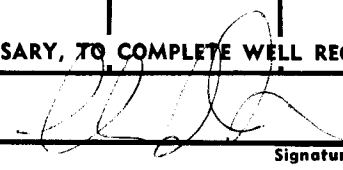
WELL LOG

Show all important zones of porosity and contents thereof; cored intervals, and all drill-stem tests, including depth interval tested, cushion used, time tool open, flowing and shut-in pressures, and recoveries.

SHOW GEOLOGICAL MARKERS, LOGS RUN,
OR OTHER DESCRIPTIVE INFORMATION.

FORMATION DESCRIPTION, CONTENTS, ETC.	TOP	BOTTOM	NAME	DEPTH
See geological report attached				

USE ADDITIONAL SHEETS, IF NECESSARY, TO COMPLETE WELL RECORD.

Date Received	 Signature	
	President	Title
	Date	