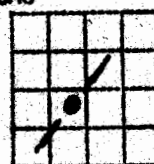


Company - SKELLY OIL COMPANY  
Farm - C. Fagerquist No. 1SEC. 22 T. 18 R. 30 W  
NE 1/4 SW  
330' FNL 330' FEL SW 1/4County. Lane  
KANSASTotal Depth. 5015'  
Comm. 4-12-45 Comp. 5-15-45  
Shot or Treated.  
Contractor. H. & T. Drilg. Co.  
Issued. 6-9-45CASING:  
10 3/4" 1195' Cem.

Elevation. \_\_\_\_\_

Production. Dry


Figures Indicate Bottom of Formations.

|                          |      |                                 |      |
|--------------------------|------|---------------------------------|------|
| surface soil             | 0-9  | lime                            | 4983 |
| clay & sand              | 130  | tan & gy coarsely xlyn          |      |
| shale                    | 925  | dolomite, no sat.               | 4988 |
| sand                     | 950  | tan & gy coarsely xlyn          |      |
| shale                    | 1200 | dolomite, por. no               |      |
| shale & lime shells      | 1280 | stains                          | 4994 |
| sand                     | 1470 | tan & gy coarsely xlyn          |      |
| red bed                  | 1625 | dolomite, very por.,            |      |
| lime                     | 1660 | no sat.                         | 5005 |
| red bed & shells         | 1820 | tan coarsely xlyn dolo-         |      |
| shale                    | 1910 | mite w/10% wh & gy              |      |
| red bed                  | 1960 | chert, por. no stain            | 5015 |
| lime                     | 1985 | Total Depth.                    |      |
| red bed                  | 2205 |                                 |      |
| anhydrite                | 2240 |                                 |      |
| red bed & shale          | 2490 | Tops:                           |      |
| sdv shale                | 2560 | Lansing lime                    | 3924 |
| lime                     | 2635 | Mississippi lime                | 4544 |
| shale                    | 2665 | Arbuckle lime                   | 4983 |
| lime & shale             | 2755 |                                 |      |
| lime                     | 2810 |                                 |      |
| lime brkn & shale        | 2930 | Sli. oil saturation 4544'-4550' |      |
| shale                    | 3105 |                                 |      |
| lime brkn                | 3185 |                                 |      |
| shale                    | 3220 |                                 |      |
| lime & shale             | 3410 |                                 |      |
| lime                     | 3470 |                                 |      |
| shale                    | 3515 |                                 |      |
| lime brkn & shale        | 3585 |                                 |      |
| lime                     | 3650 |                                 |      |
| shale                    | 3670 |                                 |      |
| lime brkn                | 3688 |                                 |      |
| lime                     | 3835 |                                 |      |
| shale                    | 3865 |                                 |      |
| sdv lime & shale         | 3930 |                                 |      |
| lime                     | 4170 |                                 |      |
| shale & lime             | 4420 |                                 |      |
| lime                     | 4475 |                                 |      |
| shale blk                | 4520 |                                 |      |
| lime                     | 4535 |                                 |      |
| shale red, lime pink,    |      |                                 |      |
| gy finely xlyn lime,     |      |                                 |      |
| & sdv lime               | 4544 |                                 |      |
| gy coarsely xlyn lime    |      |                                 |      |
| & dolomite w/wh          |      |                                 |      |
| weathered chert, sli.    |      |                                 |      |
| oil saturation           | 4550 |                                 |      |
| dense gy coarsely xlyn   |      |                                 |      |
| lime & dolomite, sli     |      |                                 |      |
| por.                     | 4554 |                                 |      |
| (On 5-9-45, ran          |      |                                 |      |
| Halliburton drill stem   |      |                                 |      |
| test, set packer @ 4540' |      |                                 |      |
| & opened 20 min., rec.   |      |                                 |      |
| 10' of drilling mud w/   |      |                                 |      |
| rainbow sh of oil.)      |      |                                 |      |
| lime                     | 4830 |                                 |      |
| lime & chert             | 4851 |                                 |      |

KANSAS

FORM 51 SM 11-44 PETROL

Lane County

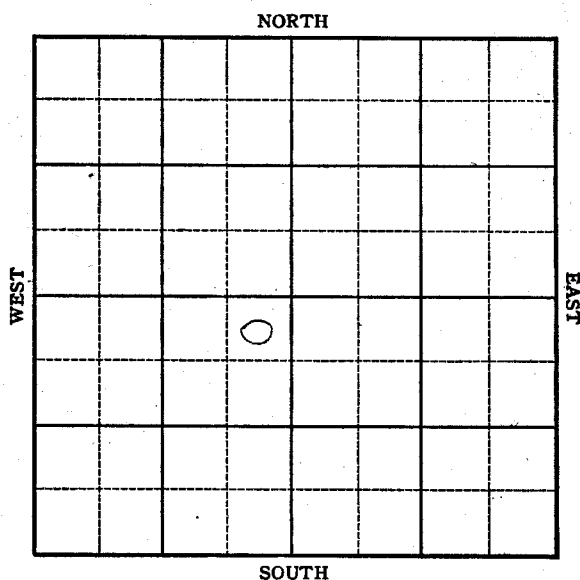Section 22 Township 18 Range 30WWell No. #1 FagerguistCompany SkellyFORM 252-A  
SM 3-45 PETROL

KANSAS

Lane County

Sec. 22 Twp. 18S R. 30WWell No. #1 Fagerguist Farm \_\_\_\_\_Company Skelly


NE SW

330 Ft. from N. Line

\_\_\_\_\_ Ft. from S. Line

330 Ft. from E. Line

\_\_\_\_\_ Ft. from W. Line

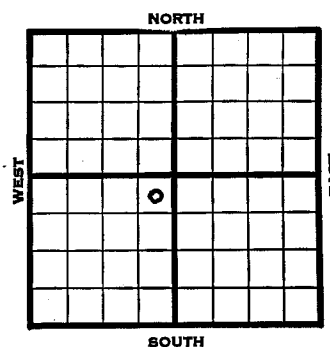

1945

REPORT

4-4 Rigging up rotary.  
 4/12 " " "  
 4/20 Drl. 930'  
 4/27 10" @ 1195  
 Drlg. 2015  
 5/3 Drlg. 3450  
 5/16 Kind 4900  
 Miss 4543  
 Arb 4983  
 TD 5015

ABANDONED

Pool Name WildcatMap No. Nmap Sec. 22 Twp. 18 R. 30WWell No. 1 FagerguistSkelly

Company

FIRST REPORT

Contractor

NE SW


## SECTION PLAT

330 Ft. from N. Line

Ft. from S. Line

330 Ft. from E. Line

Ft. from W. Line

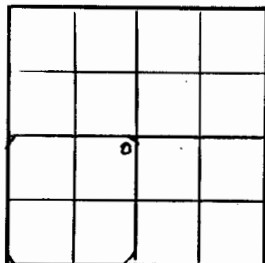

Lane

Location

Rig up

Drilling and Remarks:

RUR

## RECORD

Cased in ft.

Sand

Gas

Oil

Total Depth

## PRODUCTION

1st 24 hrs. Nat.

1st 24 hrs. after shot

Gas Cu. Ft.

Dry Hole

Abandoned

Date

APR 4 1945 19 S. J. LEWIS ScoutKansas Pool Name WildcatMap No. Nmap Sec. 22 Twp. 18 R. 30WWell No. 1 FagerguistSkelly

Company

ABANDONED

Contractor

NE SW


## SECTION PLAT

330 Ft. from N. Line

Ft. from S. Line

330 Ft. from E. Line

Ft. from W. Line

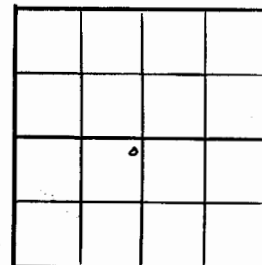

Lane County

Location

Rig up

Drilling and Remarks:

Kind 4900  
Mis 4573  
Ar 4493

## RECORD

Cased in ft.

Sand

Gas

Oil

Total Depth 5015

## PRODUCTION

1st 24 hrs. Nat.

1st 24 hrs. after shot

Gas Cu. Ft.

Dry Hole

Abandoned

Date

MAY 16 1945 19 S. J. LEWIS Scout