


Map Mc Pherson Well 1-A

Sec. 30 Twp. 18 Range 2 W

Rolander Farm

Graham Bros. Company

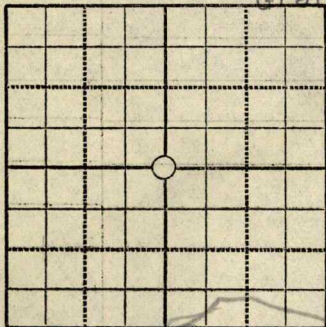

Date

SE SW SW RU

30' E of old hole

RU

500

Date

Draby
2251-5 7 5/0

1BW 2768-72

2807 more W

2816 2000' water

8/11

1535

2035

2280

2256 8"

10/5/30

2339 8", 2395 TD,

Est. 75 Bbls

State

County

McPherson

Company

Graham Bros

Well No.

19

Farm

Rolander

Survey

Block No.

Sec.

30

Twp.

18


Range

2W

Co-Ord.

SE SW SW

Elev.

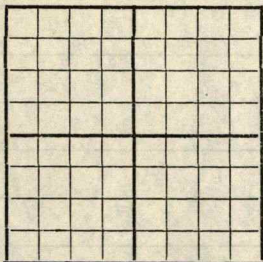

NOTE: Show Sketch of Lease and Well Location in Above Space

Ft. from N. Line

Ft. from S. Line

Ft. from W. Line

Ft. from E. Line

Date

Depth

10/22/30

20 2340-47. Inc 2395 Pump 75 Bbls

OCT 29 '30

✓

NOV 5 '30

✓

NOV 12 '30

NOV 19 '30

25 Bbls