


KANSAS

Section 21 Township 18 Range 34 W

Well No. #1 Shearmire

Company Dozier Oil

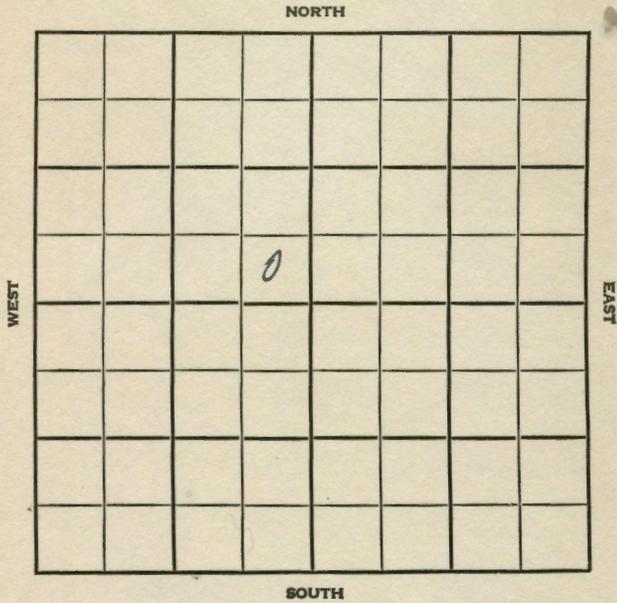

Scott

KANSAS


SEC.	TWP.	R.
21	18	34 W

WELL NO. # 1 Shearmire FARM

COMPANY Dozier Oil

CONTRACTOR Lewis Drlg. Wildcat

_____ Ft. from N. Line
 330 _____ Ft. from S. Line
 330 _____ Ft. from E. Line
 _____ Ft. from W. Line

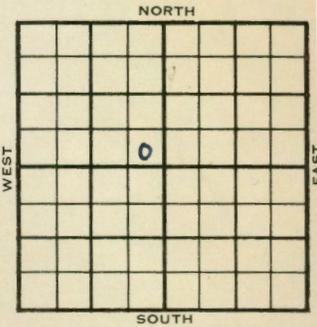

SE SE NW

EIV-3134


	ELEVATION	REPORT
--	-----------	--------

1955

3/23

Spud 3-21-55
8" @ 400

County **Scott** State **Kansas**
 Sec. **21** (Blk. Twp.) **18** (Sur. Rge.) **34W** Map No.
 Operator **Dozier Oil**
 Well No. **1** Farm **Shearmire**
 Elev. _____ Location **SE SE NW**

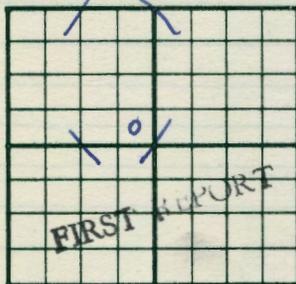

330 Ft. From **S** Line **NW**
330 Ft. From **E** Line Quarter
 1st. Report **MAR 23 1955**
 Completion _____
 Remarks _____
Lewis Drlg. - Contr.
 Spudding Date **3-21-55**

Drlg. Data **Wildcat**
8" @ 400

FABEN GILSTRAP