


NO-RECORD  
FORM 5  
O.W.W.O.

Rice KANSAS

Section 6 Township 18 Range 9 W

Well No. # 1 Disposal

Company Northern Natural

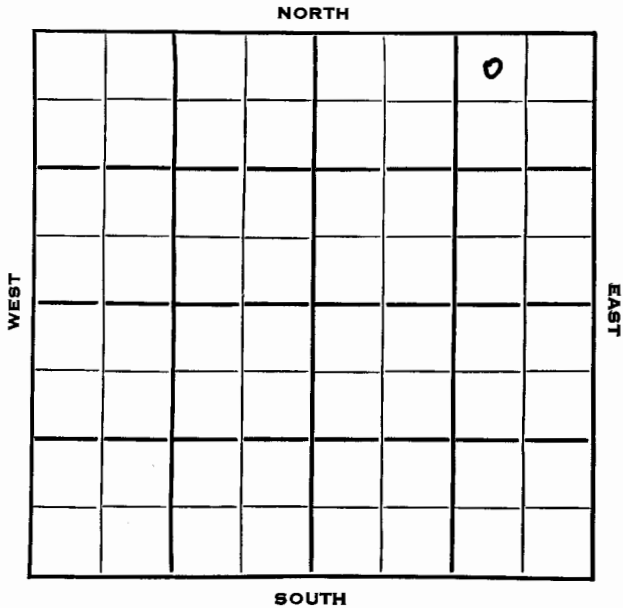

O.W.W.O.  
FORM 5  
NO-RECORD

Rice KANSAS

Sec. 6 Twp. 18 R. 9 W


Well No. # 1 Disposal Farm

Norther Natural Company

G-M-R Contractor

330 Ft. from N. Line  
 \_\_\_\_\_ Ft. from S. Line  
 990 Ft. from E. Line  
 \_\_\_\_\_ Ft. from W. Line

NW NE NE

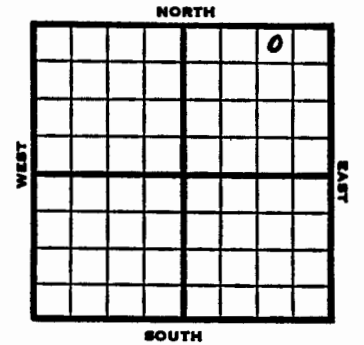

1953	Elev.-	REPORT
		O.W.W.O. NO-RECORD
8/26	OTD 1600'	8" @ 900 Heeb 2762'
	Br. line 2881'	Lans. 2902'
	Arb. 3253'	
	Drlg 3385'	
9/2	RTD 3413'	
	5" @ 3304'	
9/9	N.R.	
9/16	SWD Well	
	TD 3413	
	OTD 1600	
	8" @ 900	
	Heeb 2762, Br line 2881, Lans 2902,	
	Arb. 3253,	
	TD 3413	
	5" @ 3304	
	CO to 3413	
	Comp. for SWD Well	
		ABANDONED

