


Section 1 Township 19 Range 12-W

Well No. #1 Habiger

Company Aladdin & Crowe

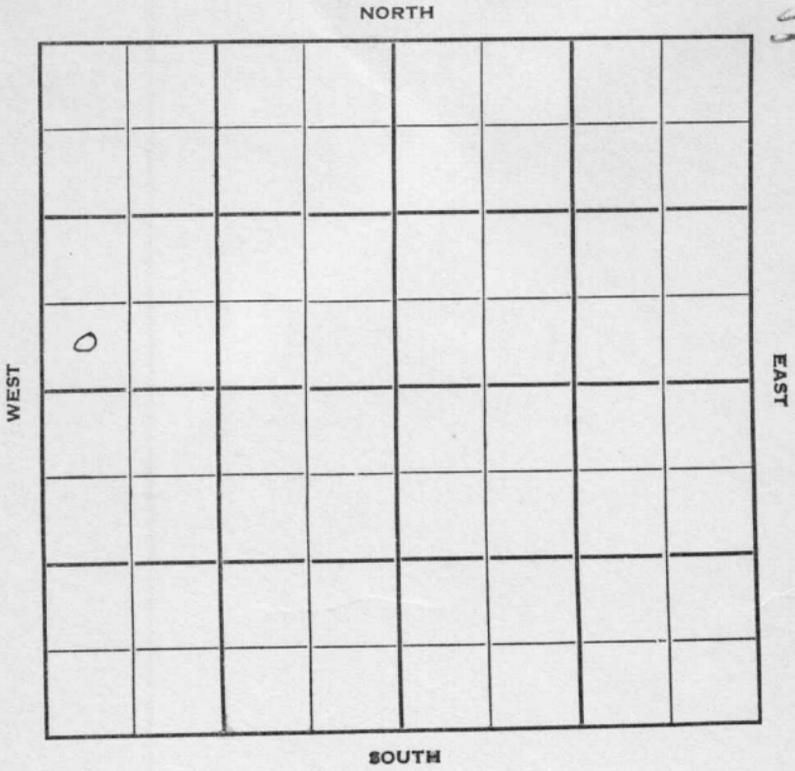


Sec. 1 Twp. 19 R. 12-W

Well No. #1 Habiger Farm
Aladdin & Crowe Company
Crowe Drlg. - Contr. Contractor

Wildcat

 Ft. from N. Line
330 Ft. from S. Line
 Ft. from E. Line
330 Ft. from W. Line

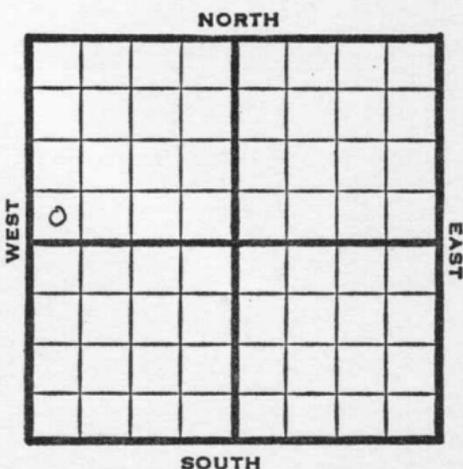

SW SW NW
Sohio farmout

1950 Elev 1830 REPORT

9/6 RUR

11/29 Spud 9-5-50
 Oil Well TD 3430
 8" @ 244 Anhy 644-85'
 Lans. 3128'
 DST 2937-65 opn 1 hr. Rec. 35' mud
 DST 3130-3202 opn 1 hr Rec. 30' so &
 gcm
 DST 3256-3310 opn 1 hr Rec. 90' socm
 Cong. 3387' DST 3389-3405 opn 1 hr
 Rec. 450' oil 5" @ 3388
 TD 3405' S/48 bo 18 hr.
 P/9½ bopd DD Arb. 3414
 TD 3430 25 go 20 gw PB 3365
 34/3337-46 22/3328-34 PB 3322
 24/3315-21 22/3283-89
 24/3270-76 ½ go 48/3250-62
 2000 A FU 750' fluid 50% oil
 S/2 bo 10 bwph PB 3205
 18/3186-92 24/3170-78
 30/3116-26 2000 A 3 bo 11 hr.
 P 28 bo 4 bwph
 Comp. 118 bopd 35% wtr.

COMPLETED

County **Barton** State **Kansas**

Sec. **1** (Blk. Twp.) **19** (Sur. Rge.) **12W** Map No.

Operator **Aladdin & Crowe**

Well No. **1** Farm **Habiger**

Elev. **1830** Location **SW SW NW**

0					

FIRST REPORT

330 Ft. From S Line NW

330 Ft. From W Line Quarter

1st. Report SEP 6 1950

Completion

Remarks

Sohio farmout

Spudding Date

Drlg. Data **Wildcat**

RUR

Scout Cards	7 W
Land Small Map	
Land Wall Map	3
Tracings	
France Map	
Pierce Map	
Misc.	

SEP 8 1950

County Barton State Kansas

Sec. 1 (Blk.) 19 (Sur.) 12W Map No. (Twp.) (Rge.)

Operator Aladdin & Crowe Drlg.

Well No. 1 Farm Habiger

Elev. 1830 Location SW SW NW

330 Ft. From S Line NW

330 Ft. From W Line Quarter

Ist. Report

Completion NOV 29 1950

Remarks Cheyenne View Pool
Crowe Drlg. - Contr.

Spudding Date 9-5-50

Drlg. Data Oil well TD 3430

8" @ 244 Anhy 644-85 Lans. 3128

DST 2937-65 open 1 hr. Rec. 35' mud

DST 3130-3202 open 1 hr. Rec. 30' so & gcm

DST 3256-3310 open 1 hr. Rec. 90' socm

Cong. 3387 DST 3389-3405 open 1 hr.

Rec. 450' oil 5" @ 3388 TD 3405

S/ 48 bo 18 hr. P/ 9 1/2 bopd

DD Arb. 3414 TD 3430 25 go 20 gw

PB 3365 34/ 3337-46 22/ 3328-34

PB 3322 24/ 3315-21 22/ 3283-89

24/ 3270-76 1/2 go 48/ 3250-62 2000 A


FU 750' fluid 50% oil S/ 2 bo 10 bwph

PB 3205 18/ 3186-92 24/ 3170-78

30/ 3116-26 2000 A 3 bo 11 hr.

J. E. TYRA

Scout Cards
Land Small Map
Land Wall Map
Tracings
France Map
Pierce Map
Misc.

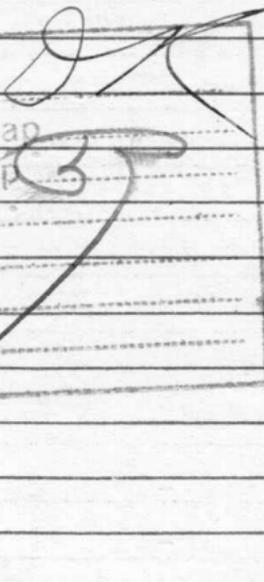

DEC 5 1950

Comp. 118 bopd 35% water

P/28 bo 4 bwpd

Drig. Data