


SECTION 1 TOWNSHIP 19 RANGE 12W

WELL NO. #1 Birzer


COMPANY Frank G. Wood

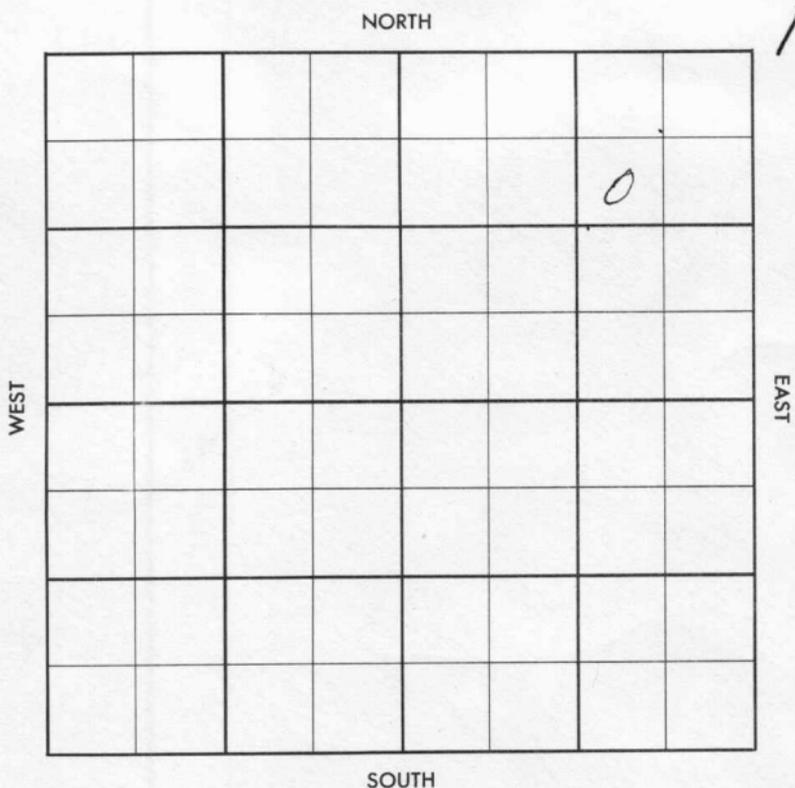



County Barton Elev. 1834 / 831 Co.  
 Sec. 1 Twp. 19 Rge. 12W  
 Company Frank G. Wood  
 Farm Name Birzer No. 1

TOPS	DEPTH	LOG	DATUM	Loc. in Sec.
Anh.	670			SW NE NE
TP.	2724			
H.	2999			
Tr.	3019			
Dg.				
Bl.	3115			
L.	3129			Geol.
K.C.				Contr.
B.K.C.				
Ce.				S & W tools
C.	3396			
M.				Pool
M.				Cheyenne View
K.				
Mz.				
Me.				
V.				
S.				
S.				
A.	3428			
R.				
PE.				
G.				COMPLETE
TD.	3431			

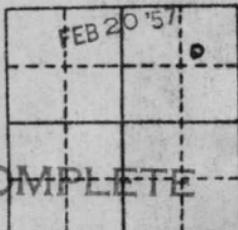

Date Comm. 12-28-56

8" @ 312 drlg. 2737 JAN 9 '57

DST 3131-62 of 1 hr 105' GCM  
BHP 140 DST 3255-93 of 1 hr  
G 1/3" rec 870' V 9554 Frothy  
oil 720/25" DST 3016-35 of  
30" rec 8' @ Md BHP 6/15  
@ 3376 JAN 16 '57 5 1/2 3429 1/2 CO  
DD 3439 TP tst 20 G-wph  
PB 3375 24/3267-73 no tst nat

Co.  
 Sec.  
 No.  
 Sec.  
 T.  
 R.

B. Flow 20 Boph. notes 104

JAN 23 '57    JAN 30 '57    FEB 6 '57    FEB 13 '57    FEB 20 '57

P. 25 Bopd no/wtr.

1-19-12W

sw ne ne