


Section 1 Township 19 Range 12W

Well No. 1/4 Heinz "B"

Company Sohio Petroleum

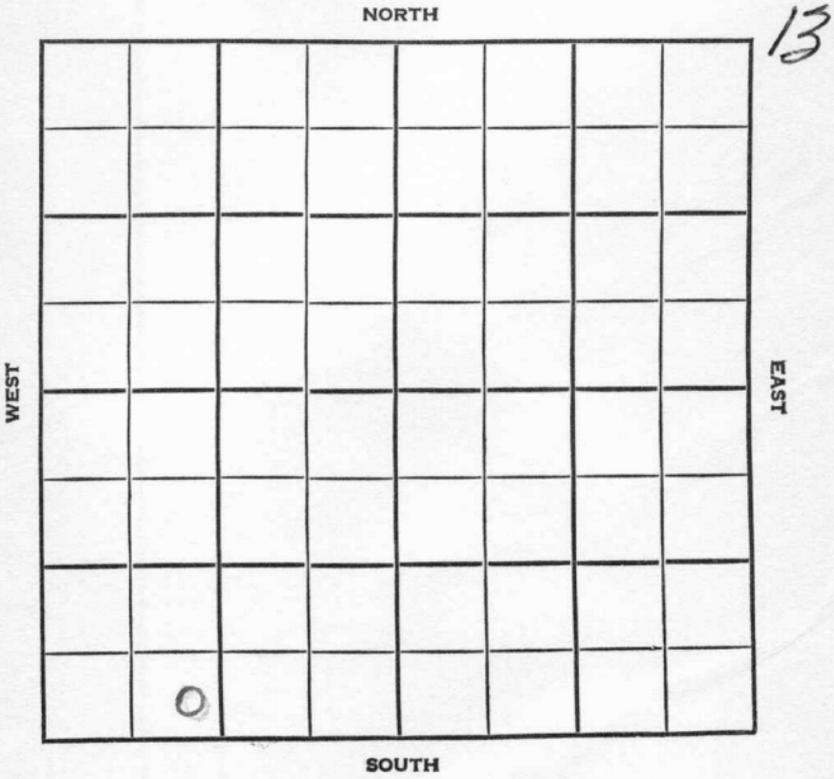


Barton KANSAS  
 SEC. 1 TWP. 19 R. 12W

WELL NO. #4 Heinz "B" FARM

COMPANY Sohio Pet.

CONTRACTOR B&B

\_\_\_\_\_ Ft. from N. Line  
 \_\_\_\_\_ Ft. from S. Line  
 \_\_\_\_\_ Ft. from E. Line  
 \_\_\_\_\_ Ft. from W. Line

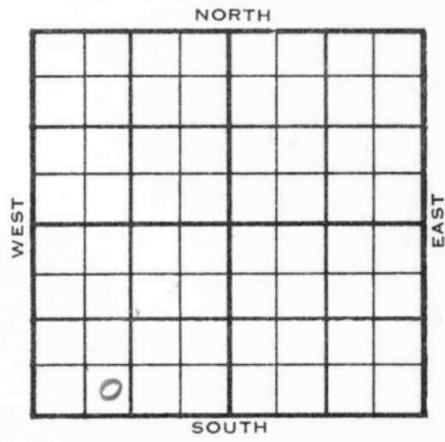

SE SW SW

1955	ELEVATION	REPORT
	1827	
7/6	MIE	
8/31	Comm 7-7-55 Anh 653 H 2974 B1 3090 L 3107 A 3402 TD 3408 8 5/8" @ 662/350 DST 3118-38 open 1 hr Rec 135' g & OCM 120' Geo 240/20" DST 3262-88 open 1 hr Rec 60' mco 180' <del>EW</del> ocw 120' SW 5 1/2" @ 3407/125 CO to 3407 B/5 goph 500 A s/3 boph 10 hr 1000 A S/25 boph 14 hr P/ <del>13</del> 220 bopd Comp 22 bopd	
		COMPLETED

County Barton Elev. \_\_\_\_\_  
 Sec. 1 Twp. 19 Rgs. 12W  
 Company Sohio Petroleum  
 Farm Name Heinz "B" No. 4

Co.  
Lse.  
No.  
Sec.  
T.  
R.

TOPS	DEPTH	LOG	DATUM
Anh.			
T.P.			
H.			
Tr.			
Dg.			
B.L.			
L.			
K.C.			
B.K.C.			
Ce.			
C.			
M.			
M.			
K.			
Mz.			
Me.			
V.			
S.			
S.			
A			
R.			
PE.			
G.			
T.D.			

Loc. in Sec. SE SW SW  
 Geol. \_\_\_\_\_  
 Contr. B & B  
 Pool Cheyenne View  
 FIRST REPORT  
 JUL 6 '55

Date Comm. M I R

*Handwritten signature*

JUL 8 1955

Scout Cards

Lar • Small Map

Land Wall Map

Tracings

Franchise Map

Pledge Map

Misc.

J.C.

County Barton Elev. 1827  
 Sec. 1 Twp. 19 Rgs. 12W  
 Company Sohio Pet.  
 Farm Name Heinz "B" No. 4

TOPS	DEPTH	LOG	DATUM
Anh.	653		
Tp.			
H.	2974		1147
Tr.			
Dg.			
B.L.	3090		1263
L.	3107		1280
K.C.			
B.K.C.			
Ce.			
C.		3371	1544
M.			
M.			
K.			
Mz.			
Mo.			
V.			
S.			
S.			
A.	3402		1575
R.			
PE.			
G.			
T.D.	3408		

Loc. in Sec. SE SW SW  
 Geol. \_\_\_\_\_  
 Contr. \_\_\_\_\_  
 Pool Cheyenne View



Date Comm. 7-7-55 AUG 31 1955  
8 5/8" @ 662/350 DST 3118-38 open 1 hr.  
Rec. 135' g & ocm 120' gco 240/20"  
DST 362-88 open 1 hr. Rec. 60' mco  
180' ocw 120' sw 5 1/2" @ 3407/125  
CO to 3407 B/ 5 boph 500A S/ 3 boph  
10 hr. 1000 A S/ 25 boph 1 1/4 hr.  
P/ 220 bopd Comp. 22 bopd

Co.  
 Lse.  
 No.  
 Sec.  
 T.  
 R.

SEP 8 1955

Scout Cards	<u>mm<sup>c</sup></u>
Land Small Map	_____
Land Wall Map	_____
Tracings	_____
France Map	_____
Pierce Map	_____
Misc.	_____