


Section 1 Township 19 Range 12W

Well No. #3 Heinz "B"

Company Sohio Pet.

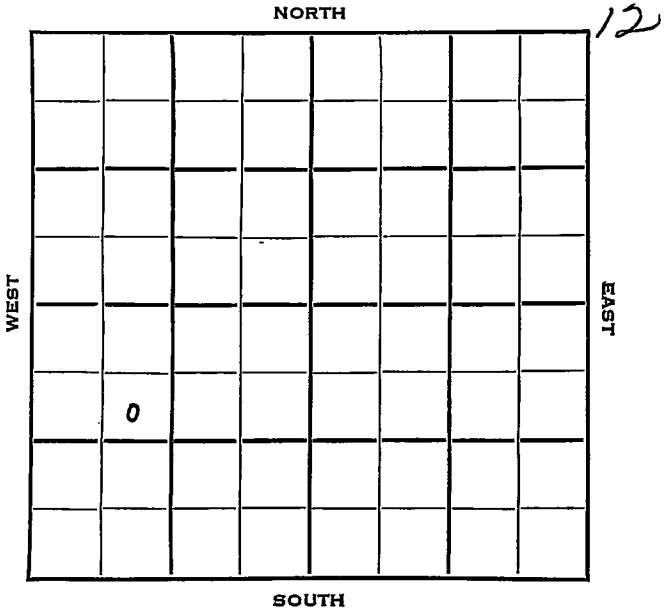

SEC.	TWP.	R.
1	19	12W ✓

WELL NO. 3 Heinz "B" FARM

COMPANY Sohio Petr.

CONTRACTOR Mast Drlg.


Cheyenne View Pool

990 Ft. from N. Line

Ft. from S. Line

Ft. from E. Line

990 Ft. from W. Line

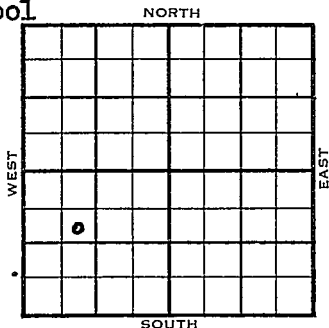

SE NW SW

	ELEVATION	REPORT
1954	1827'	.

3/3 Spud 2-28-54  
Anhy 665'  
8" @ 673'  
WOC

3/10 Heeb 2994', Br li 3110', Lans 3124'  
DST 3125-35', 1 hr., 8' M, Off  
Drlg. 3215'

3/17 Cong 3395'  
DST 3250-70', 1 hr., 390' gas, 30'  
SO&GCM, 75#  
DST 3312-30', 1 hr., 6' M  
Drlg. 3395'

3/24 RTD 3424'  
Arb. 3417'  
5" @ 3420'  
CO 3424'  
500A  
B/28 gw 1st hr.  
DD 3434'  
TD Wtr.-

3/31 DD 3437'

4/7 Spud 2-28-54  
Oil Well  
TD 3437'

OVER

1954

Information brought forward.

4/7

Anhy 665'

8" @ 673'

Heeb 2994', Br. Lime 3110', Lans  
3124'

DST 3125'-35' opn 1 hr, rec 8' Mud Off  
Cong 3395'

DST 3250'-70' opn 1 hr, rec 390' gas  
30' so & gcm 75#

DST 3312'-30' opn 1 hr, rec 6' Mud Off  
TD 3424'

Arb 3417'

5" @ 3420'

CO to 3424'

500 A B/ 28 gw 1 hr.

DD 3434' wtr.

DD 3437'

24 gfph SP 3400

16/ 3326-30 16/ 3280-84

32/ 3260'-68' 2000 A S/ 105 bo

126 bw 21 hr.

Comp 72 bopd 72 bw

**COMPLETED**

County **Barton** State **Kansas**

Sec. **1** (Blk.) **19** (Sur. Rge.) **12W** Map No.

Operator **Sohio Pet.**

Well No. **3** Farm **Heinz "B"**

Elev. Location **SE NW SW**


**990** Ft. From **N** Line **SW**

**990** Ft. From **W** Line Quarter

1st. Report **MAR 3 1954**

Completion

Remarks

**Mast Drlg. - Contr.**

Spudding Date **2-28-54**

Drlg. Data **Cheyenne View Pool**

**Anhy 665 8" @ 673 WOC**

MAR 3 1954

Scout Cards	<u>        </u>
Land Small Map	<u>        </u>
Land Wall Map	<u>        </u>
Tracings	<u>        </u>
France Map	<u>        </u>
Pierce Map	<u>        </u>
MISC.	<u>        </u>

Orig. Data

County Barton State Kansas  
 Sec. 1 (Blk.) 19 (Sur.) 12W Map No.  
 Operator Sohio Pet.  
 Well No. 3 Farm Heinz "B"  
 Elev. 1827 Location SE NW SW

<b>COMPLETE</b>									

990 Ft. From N Line SW  
 990 Ft. From W Line Quarter  
 Ist. Report  
 Completion APR 7 1954  
 Remarks Cheyenne View Pool  
Mast Drlg. - Contr.  
 Spudding Date 2-28-54

Drlg. Data Oil well TD 3437  
Anhy 665 8" @ 673 Heeb. 2994  
Br. lime 3110 Lans. 3124 DST 3125-35  
open 1 hr. Rec. 8' mud O# Cong. 3395  
DST 3250-70 open 1 hr. Rec. 390' gas  
30' so & gem 75# DST 3312-30 open 1 hr  
Rec. 6' mud O# TD 3424 Arb. 3417  
5" @ 3420 GO to 3424 500 A B/ 28 gw  
1 hr. DD 3434 wtr. DD 3437  
24 gph SP 3400 16/ 3326-30 16/ 3280-  
84 32/ 3260-68 2000 A S/ 105 bo  
126 bw 21 hr. Comp. 72 bopd 72 bw

APR 12 1954  
M  
T  
L 31 5  
C M 5  
Mis

Drig. Data