


Section 1 Township 19 Range 12W

Well No. #2 Heinz (B)

Company Sohio

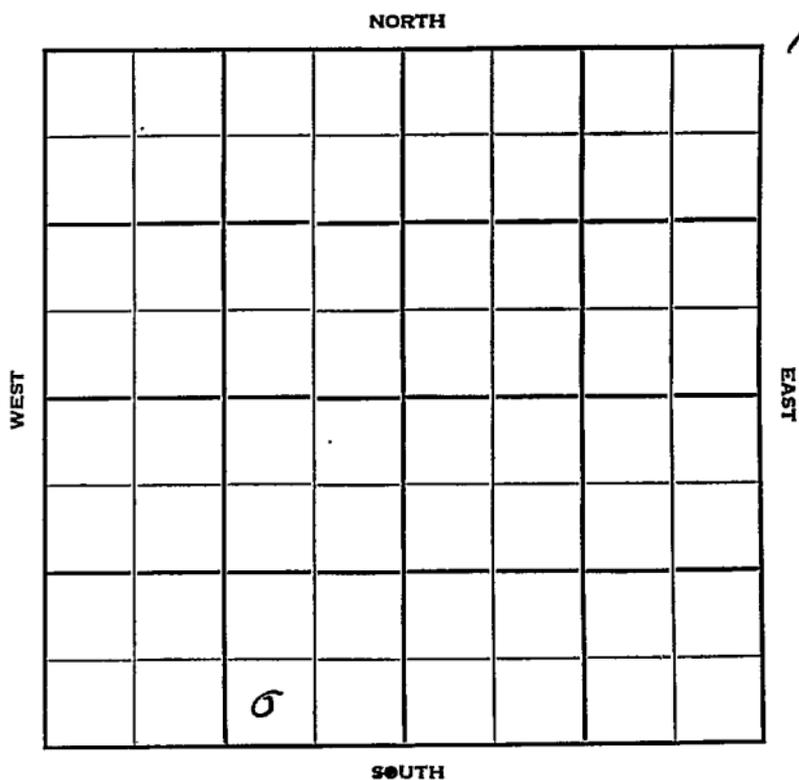

Sec. 1 Twp. 19 R. 12W

Well No. #2 Heinz (B) Farm

Sohio Company

Contractor

Chey View


\_\_\_\_\_ Ft. from N. Line

330' Ft. from S. Line

990' Ft. from E. Line

\_\_\_\_\_ Ft. from W. Line

SW SE SW

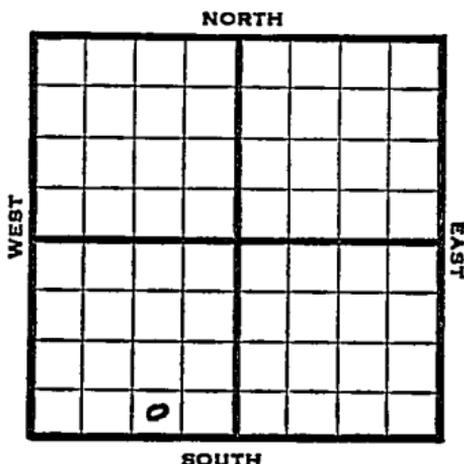

1952

Elev. 1826' REPORT

7/2

Location --- --

7/9

8" @ 633 Anhy 636'

7/17

Drig. 1935'

7/23

Topeka 2711 Heeb. 2974  
Br Li 3089 Lans. 3106  
Arb. 3410-15

RTD 5" @ 3413' CO

7/30

CO 3415' dry DD 3417 SO 500 A  
S/ 77.8 BO 8 hr.

8/6

NR

8/13

Spud 7-6-52  
Oil Well TD 3417'  
8" @ 633'  
Anhy 636 Top. 2711  
DST 2914-25 open 1 hr. rec. 600' gas  
63' HO&GCM 930# Heeb. 2974  
Br Li 3089 Lans. 3106  
DST 3108-22 open 1 hr. rec. 2200'  
gas 90' SO&GCM 380#  
DST 3129-45 open 1 hr. gas in 10 min.  
rec. 90' M&GCO 240' GCO 610#  
DST 3188-95 open 1 hr. gas in 15 min.  
Rec. 180' M&GCO 150' gco 50' sw  
990# Arb. 3410 TD 3415  
5" @ 3413 CO to 3415 Dry DD 3417  
SO 500 A S/ 78 bo 8 hr.  
Comp. 101 bopd 18% wtr.

COMPLETED



JUL 7 1952

Scout Cards .....	OK
Land Small Map .....	
Land Wall Map .....	3
Tracings .....	
France Map .....	
Pierce Map .....	
Misc. ....	



Scout Cards .....	3
Land Small Map .....	
Land Wall Map .....	3
Tracings .....	
France Map .....	
Pierce Map .....	
Misc .....	

AUG 27 1952