

Barton


KANSAS

SECTION 1 TOWNSHIP 19S RANGE 11W

WELL NO. #1 Wendel

COMPANY Nadel-Gussman

NORTH <sup>SE</sup> SE NE

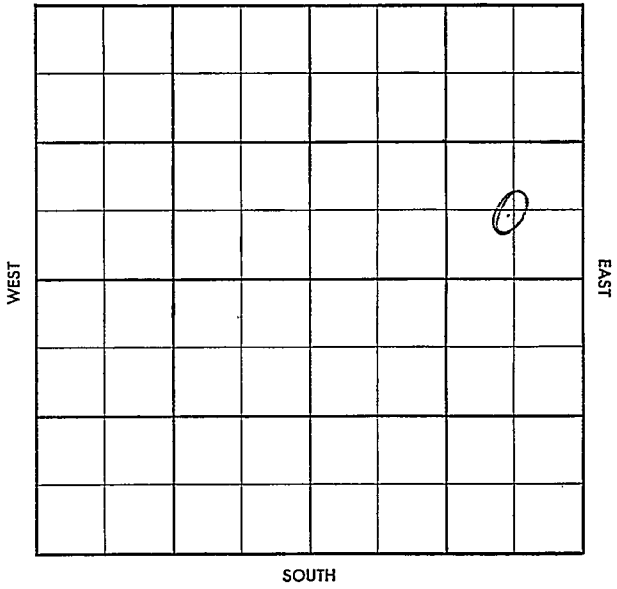

43

S-513-B

County Barton Elev. \_\_\_\_\_  
 Sec. 1 Twp. 19 Rge. 11W  
 Company Nadel-Gussman  
 Farm Name Wendel No. 1

TOPS	DEPTH	LOG	DATUM
Anh.			
Tp.			
H.			
Tr.			
Dg.			
B.L.			
L.			
K.C.			
B.K.C.			
Ce.			
C.			
M.			
M.			
K.			
Mz.			
Mq.			
V.			
S.			
S.			
A.			
R.			
Pf.			
G.			
T.D.			

Loc. in Sec. C SE NE  
 Geol. \_\_\_\_\_  
 Contr. \_\_\_\_\_  
Reserve Drlg.  
 Pool \_\_\_\_\_  
Mary Ida So.

JAN 22 1958  
**FIRST REPORT**

Date Comm. 1/17/58, 8" @ 201 Drlg. 2400.

Co.  
Lse.  
No.  
Sec.  
T.  
R.