

KANSAS


Barton

FORM 51 5M 1-42 PETROL

Section 1 Township 19 Range 11-W

Well No. #2 Musenberg

Company Stanolind

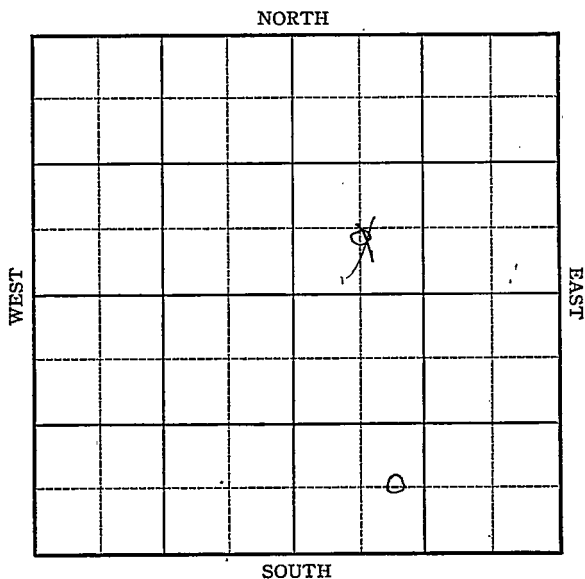

KANSAS

Barton

Sec. 1 Twp. 19 R. 11-W

Well No. #2 Musenberg Farm

Stanolind Company

Rick


 Ft. from N. Line

660 Ft. from S. Line

 Ft. from E. Line

990 Ft. from W. Line

Elev. 1777

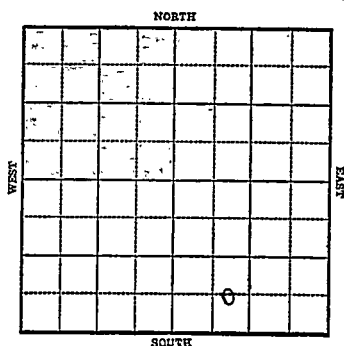

1943

R E P O R T

3/24 Derrick
3/31 10" @ 202'
Anhy 547'
Drlg. 1490'
4/7 Dlg. 2880
4/14 Lans 3045
Arb. 3383
Drlg. 3403'
Show water.
4/21 Arb. 3383
T.D. 3418'
No shows.

ABANDONED

Barton

KANSAS

Map No. 46 Sec. 1 Twp. 19 R. 11WWell No. 2 MusenberglStanolind

Company

FIRST REPORT

Contractor

C EL SW SE

SECTION PLAT

 Ft. from N. Line660 Ft. from S. Line Ft. from E. Line990 Ft. from W. Line

RICK POOL

Location Rig up

Drilling and Remarks:

Derrick

RECORD

Cased in., ft.Sand Gas Oil Total Depth

PRODUCTION

1st 24 hrs. Nat. 1st 24 hrs. after shot Gas Cu. Ft.Dry Hole Abandoned

Date

MAR 24 1943

19

S. J. LEWIS

Scout

Barton

KANSAS
 Map No. 246 Sec. 1 Twp. 19 R. 11W

Well No. 2 Musenberg

Stanolind Company

ABANDONED Contractor

C EL SW SE


SECTION PLAT

 Ft. from N. Line

660 Ft. from S. Line

 Ft. from E. Line

990 Ft. from W. Line

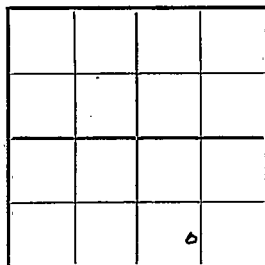

RICK POOL

Location

Rig up

Drilling and Remarks:

Ar x 38 83

Noz howe

RECORD

Cased in., ft.

Sand

Gas

Oil

Total Depth 2418

PRODUCTION

1st 24 hrs. Nat.

1st 24 hrs. after shot

Gas Cu. Ft.

Dry Hole

Abandoned

Date

APR 21 1943 19 S. J. LEWIS Scout