

KANSAS

Form 51—5M—7-40—Palace


Barton

Section 1 Township 19 Range 11-W

Well No. #1 Musenberg "B"

Company Stanolind

NORTH Wildcat

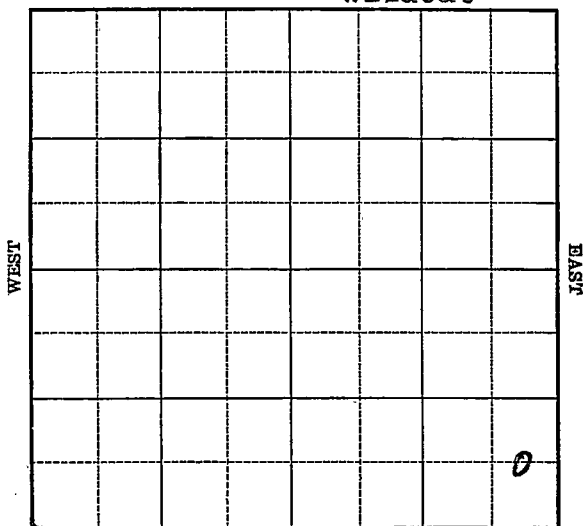


SOUTH

Sec. 1 Twp. 19 R. 11-WWell No. #1 Musenberg "B" FarmStanolind Company

(Wildcat)

 Ft. from N. Line660 Ft. from S. Line330 Ft. from E. Line Ft. from W. Line

Elev. 1782

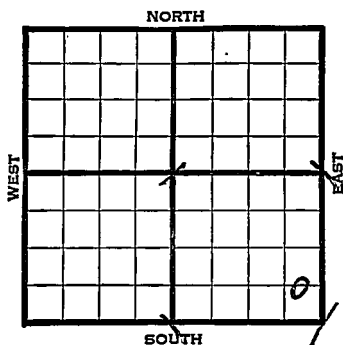

1940	REPORT
12/4	Location
12/12	R.U.R.
12/19	8" - 230' Anhy 525'
	Drlg. 1750'
12/26	Drlg. 2953'
1941	
1/2	Arb. 3353-60' T.D. 5" - 3353'
	RUST.
1/9	SSO 3364' T.D. Shot 10 qts
	3357-64' C.O.
1/16	T.D. 3377' Swab 6 gals. oil per
	hour.
1/22	Arb. 3353'
	5" - 3353'
	T.D. 3377'
	Shot 10 qts. 3357-64'
	3120 acid.
	Potential 64 bbls., pump.
	45. Gravity
	COMPLETED


Map No. 46 Sec. 1 Twp. 19 R. 11WWell No. 1 MusenbergStanolind

Company

Contractor

FIRST REPORT

C E L SE SE

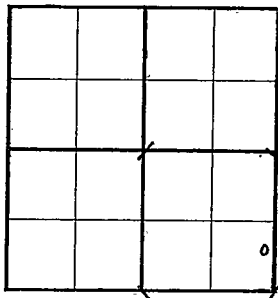SECTION PLAT Ft. from N. Line660 Ft. from S. Line330 Ft. from E. Line Ft. from W. Line

WILDCAT

Location XRig up

Drilling and Remarks:

RECORDCased in., ft.Sand Gas Oil Total Depth **PRODUCTION**1st 24 hrs. Nat. 1st 24 hrs. after shot Gas Cu. Ft.Dry Hole Abandoned

Date

DEC 4 1940 19S. J. LEWIS


Scout

Map No. 46 Sec. 1 Twp. 19 R. 11WWell No. 1 Musenberg "B"Stanolind CompanyCORRECTION Contractor

C E L S E S E

 Ft. from N. Line660 Ft. from S. Line330 Ft. from E. Line Ft. from W. Line

WILDCAT

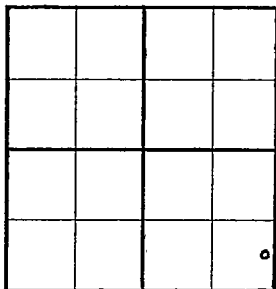SECTION PLATLocation Rig up

Drilling and Remarks:

Reported

as #1 Musenberg

RECORDCased in., ft.Sand Gas Oil Total Depth **PRODUCTION**1st 24 hrs. Nat. 1st 24 hrs. after shot Gas Cu. Ft.Dry Hole Abandoned

Date

DEC. 12 1940 19 S. J. LEWIS Scout

