


KANSAS

Section.....1.....Township.....19.....Range.....11W.....

Well Number.....2.....Rick.....

Company.....Rose Spring et al.....

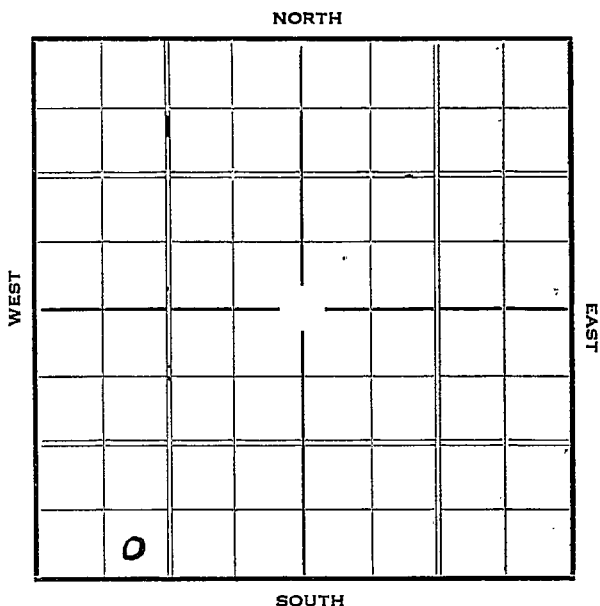

1937

4/21 Sil. 3384'.

T.D. 3425'.

No show oil or water.

~~ABANDONED~~ ~~COMPLETED~~ ~~ABANDONED~~

KANSAS

Map No. 46 Sec. 1 Twp. 19 R. 11WWell No. 2 RickRose Spring & Co Company

Contractor

Special

SECTION PLAT

_____ Ft. from N. Line

330 Ft. from S. Line

_____ Ft. from E. Line

990 Ft. from W. Line

FIRST REPORT

Location ✓

Rig up _____

Drilling and Remarks:

RECORD

Cased _____ in., _____ ft.

Sand _____

Gas _____

Oil _____

Total Depth _____

PRODUCTION

1st 24 hrs. Nat. _____

1st 24 hrs. after shot _____

Gas _____ Cu. Ft.

Dry Hole _____

Abandoned _____

Date

NOV 10 1936 19

S. J. LEWIS Scout

Paul

Returned	
Cards	<i>Paul</i>
Tracing	<i>Joe</i>
France Map	<i>✓</i>
Scarborough Map	<i>✓</i>
Moody Map	<i>✓</i>
Scarborough Plat Book	<i>✓</i>
Moody Plat Book	<i>✓</i>

KANSAS *Bar ton*Map No. _____ Sec. 1 Twp. 19 R. 11W.Well No. 2. RickRose Spring et al Company_____
Contractor**SECTION PLAT**

Ft. from N. Line330 Ft. from S. Line_____
Ft. from E. Line990 Ft. from W. Line**ABANDONED****RECORD**

Location _____

Cased _____ in., _____ ft.

Rig up _____

Sand _____

Drilling and Remarks:

Gas _____

Oil _____

Total Depth 3425**PRODUCTION**

1st 24 hrs. Nat. _____

1st 24 hrs. after shot _____

Gas _____ Cu. Ft.

Dry Hole ☒Abandoned ☒

Date

APR 21 1937 19S. J. LEWIS Scout

Ray

Returned

Cards

Tracing

France Map

Scarborough Map

Moody Map

Scarborough Plat Book

Moody Plat Book