


Section 1 Township 19 Range 11-W

Well No. #1 Rick "B"

Company Ed Jonas

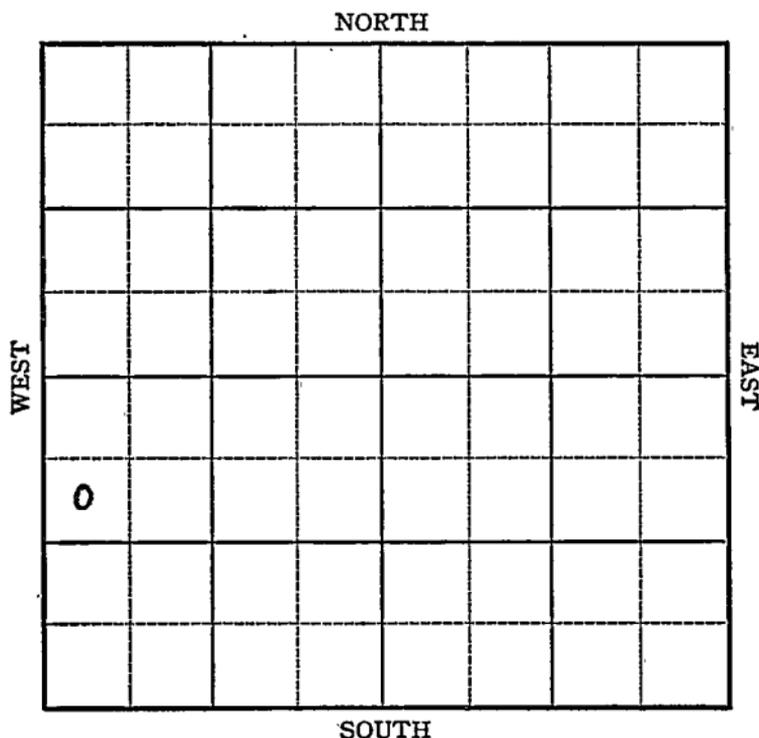

Sec. 1 Twp. 19 R. 11-W

Well No. #1 Rick "B" Farm

Ed Jonas Company

(Rick)


990 Ft. from N. Line

_____ Ft. from S. Line

_____ Ft. from E. Line

330 Ft. from W. Line

Elev. 1767

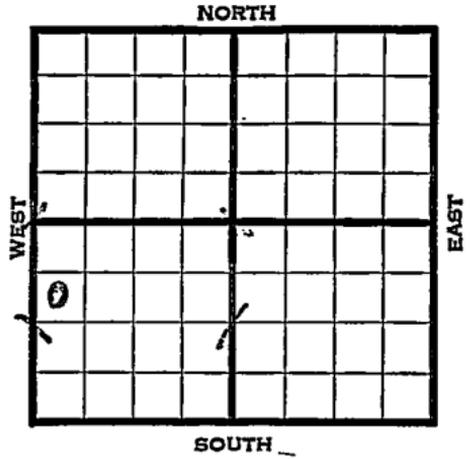

1941	REPORT
11/25	8" - 148' Anhy 540'
	Lans. 3018' Drlg. 3112'
12/4	T.D. 3387' S.D.
12/10	Arb. 3377'
	T.D. 3387'
	No shows.
	ABANDONED

Barton

KANSASMap No. K-46 Sec. 1 Twp. 19 R. 11WWell No. 1 Rick "B"Ed Jonas CompanyFIRST REPORT Contractor


SW NW SW

SECTION PLAT

990 Ft. from N. Line

_____ Ft. from S. Line

_____ Ft. from E. Line

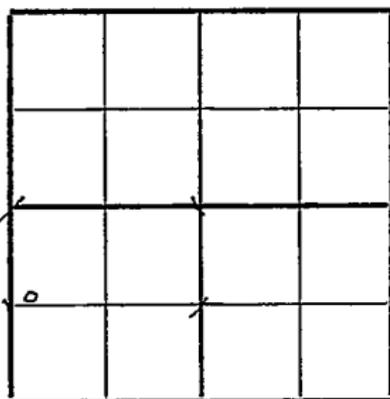330 Ft. from W. Line

RICK POOL

Location _____

Rig up _____

Drilling and Remarks:

8" - 148'

Anhy. 540'

Lans. 3018'

Drlg. 3112'

RECORD

Cased _____ in., _____ ft.

Sand _____

Gas _____

Oil _____

Total Depth _____

PRODUCTION

1st 24 hrs. Nat. _____

1st 24 hrs. after shot _____

Gas _____ Cu. Ft.


Dry Hole _____

Abandoned _____

Date

NOV 25 1941 19S. L. LEWIS Scout

7 10 10 10 10

 

W
I
W

W. C. S.

Misc Small Maps	
Cards	
Tracing	
France Map	
Scarborough Map	
Moody Map	
Geological Dept.	
Moody Flat Book	

Map No. 46 Sec. 1 Twp. 19 R. 11WWell No. 1 Rick "B"Ed Jonas CompanyABANDONED Contractor

SW NW SW

SECTION PLAT

990 Ft. from N. Line

_____ Ft. from S. Line

_____ Ft. from E. Line

330 Ft. from W. Line

RICK POOL

RECORD

Location _____

Cased _____ in., _____ ft.

Rig up _____

Sand _____

Drilling and Remarks:

Gas _____

Oil _____

Total Depth 3387CR 8337No shows

PRODUCTION

1st 24 hrs. Nat. _____

1st 24 hrs. after shot _____

Gas _____ Cu. Ft.

Dry Hole _____

Abandoned _____

Date

DEC 1 0 1941 19S. J. LEWIS Scout

Misc. Small Maps	<i>MAJ</i>
Cards	<i>MAJ</i>
Tracing	<i>MAJ</i>
France Map	<i>MAJ</i>
Scarborough Map	<i>MAJ</i>
Moody Map	<i>MAJ</i>
Geological Dept.	_____
Moody Plat Book	_____