


Section 1 Township 19 Range 11W

Well No. #1 Wendel

Company F. G. Holl

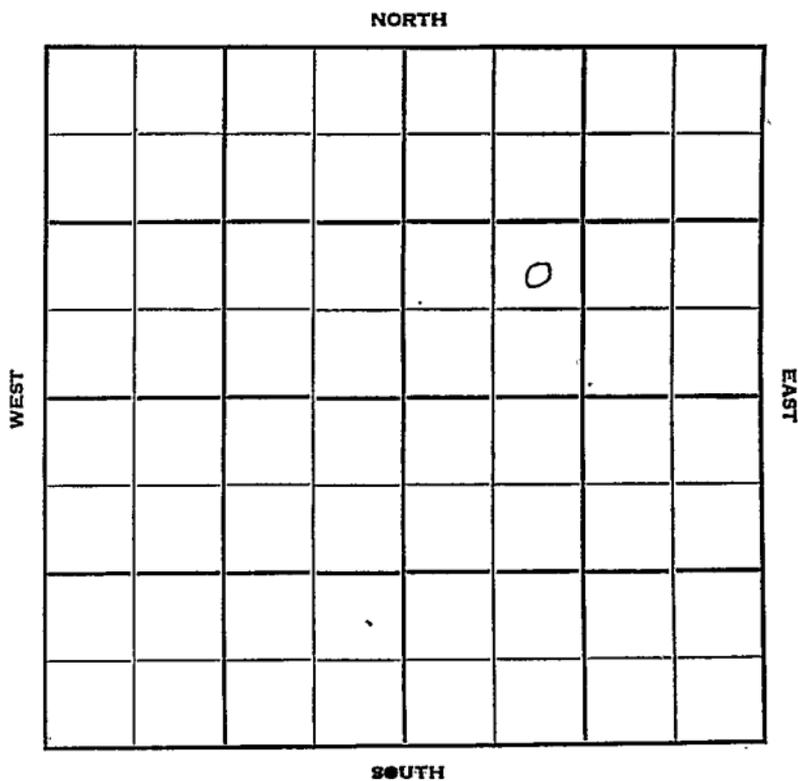

Barton

KANSAS ✓

Sec. 1 Twp. 19 R. 11W

Well No. #1 Wendel Farm

F. G. Holl Company

Herndon Drlg. - Contr. Contractor

Wildcat


Ft. from N. Line

990' Ft. from S. Line

Ft. from E. Line

990' Ft. from W. Line

NE SW NE

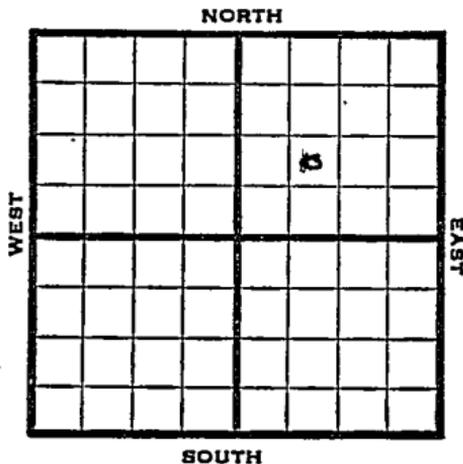

1950

Elev. 1766' REPORT

11/29

Spud 11-28-50

1951

1/3

Spud 11-28-50

D&A TD 3417

8" @ 170'

Heeb. 2905 Br Lime 3025

Lans. 3043

DST 3200-21 opn 45 min

Rec. 145' clean oil 10' ocm

Cong. 3352-3417 5" @ 3416

24/3209-13 12/3209-13 24/3192-98

2000 A Est. 60 bopd dec to wtr

D&A

ABANDONED


County Barton State Kansas

Sec. 1 (Blk.) 19 (Sur. Rge.) 11W Map No.

Operator F. G. Holl.

Well No. 1 Farm Wendel

Elev. _____ Location NE SW NE

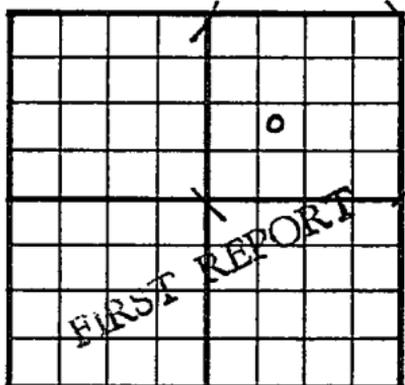

990 Ft. From S Line NE

990 Ft. From W Line Quarter

Ist. Report NOV 29 1950

Completion _____

Remarks _____

Herndon Drig. - Contr.

Spudding Date 11-28-50

Drlg. Data Wildcat

