

Section 1 Township 19 Range 10N

Well No. #3 Behnke

Company Cities Service
Chase Pool

NORTH

							⊙

WEST

EAST

SOUTH



Sec. 1 Twp. 19 R. 10W

Well No. #3 Behnke Farm

Cities Service Company


Cahse Pool

 Ft. from N. Line

990 Ft. from S. Line

330 Ft. from E. Line

 Ft. from W. Line

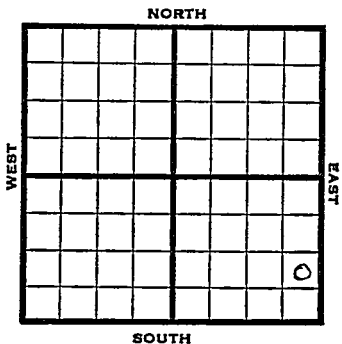

NE SE SE

1948

Elev. 1717' REPORT

4/21

8" @.269'
Drlg. 1223'

4/28

Lansing 2892'
Arbuckle 3250-51'
TD 3251'
5" @@ 3251'
RUST

5/5

"

5/12

40 shots 2955-67 - 1000 Acid
Flow 215 bbls oil 15 hrs.

5/19

Arbuckle 3250'
5" @ 3251'
Perf.
1000 Acid
Bomb Pot 1257 oil
Gr. 42°
TD 3251'

COMPLETED

Map No. _____ Sec. 1 Twp. 19 R. 10^W

Well No. 3 Behnke

Cities Service _____ Company

FIRST REPORT

Contractor _____

NE SE SE

SECTION PLAT

			o

_____ Ft. from N. Line

990 Ft. from S. Line

330 Ft. from E. Line

_____ Ft. from W. Line

Rice County

Location _____

Rig up _____

Drilling and Remarks:

8" @ 269

drlg. 12'23

RECORD

Cased _____ in., _____ ft.

Sand _____

Gas _____

Oil _____

Total Depth _____

PRODUCTION

1st 24 hrs. Nat. _____

1st 24 hrs. after shot _____

Gas _____ Cu. Ft.

Dry Hole _____

Abandoned _____

Date

APR 21 1948 19 _____ S. J. LEWIS Scout

