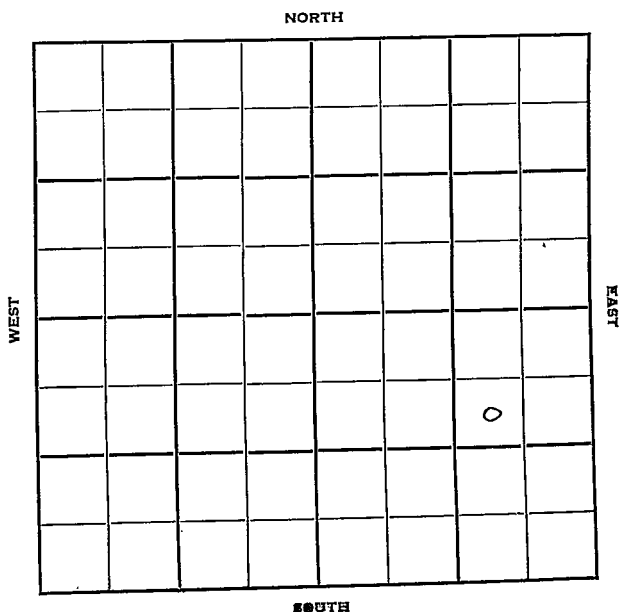


Section 1 Township 19 Range 10WWell No. #6 BehnkeCompany Cities Service

Rice

KANSAS

Sec. 1 Twp. 19 R. 10 W

Well No. # 6 Behnke Farm

Cities Service Company

Contractor

Chase Pool


940 Ft. from N. Line

Ft. from S. Line

900 Ft. from E. Line

Ft. from W. Line

SW NE SE

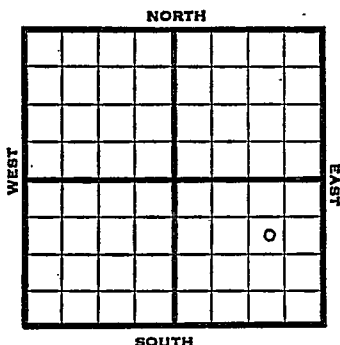

1951

Elev. 1717 REPORT

8/8

Location

9/12

Spud 8-13-51

Oil Well TD 3247

KC 2889 Cong. 3233

Eros Arb. 3239 Solid Arb. 3241

5" @ 3242 TD 3247

FU 2456 oil 17 hr. P/106 bo 14 hrs.

Comp. 156 bopd

COMPLETED

J. E. TYRA

County Rice State Kansas
 Sec. 1 (Blk.) 19 (Sur.) 10W Map No.
 Operator Cities Service
 Well No. 6 Farm Behnke
 Elev. 1717 Location SW NE SE

940Ft. From N Line SE
 900Ft. From E Line Quarter
 1st. Report
 Completion SEP 12 1951
 Remarks Chase Pool
Barbour Drlg. - Contr.
 Spudding Date 8-13-51

Drlg. Data Oil well TD 3247
KC 2889 Cong. 3233 Eros. Arb. 3239
Solid Arb. 3241 5" @ 3242 TD 3247
FU 2456' oil 17-hr. P/ 106 bo 14 hr.
Comp. 156 bopd

J. E. TYRA