


Section 1. Township 19 Range 10 W

Well No. # 1 Behnke

Company Rex & Morris

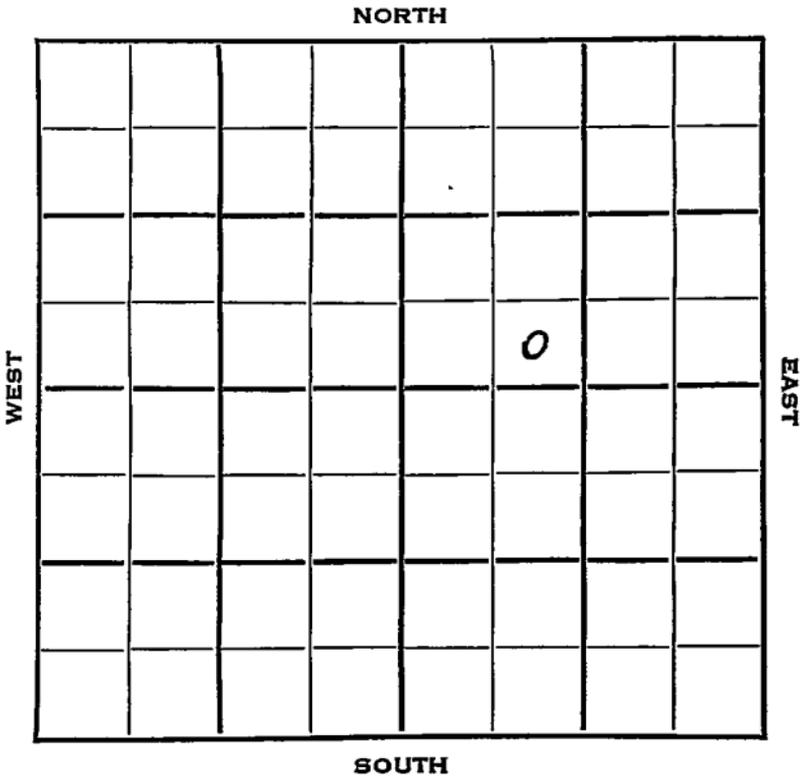

KANSAS

Sec. 1 Twp. 19 R. 10W

Well No. #1 Behnke Farm

Rex & Morris Company

Contractor

Chase-Silica Pool


Ft. from N. Line

330 Ft. from S. Line

Ft. from E. Line

990 Ft. from W. Line

SE SW NE

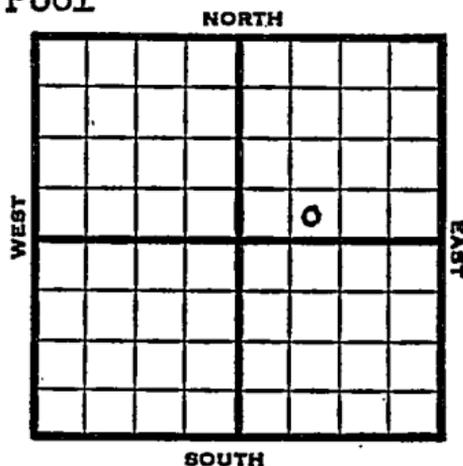

1953 Elev. 1723' REPORT

8/5 Location

8/12 8" @ 187
Drlg. 1740'

8/19 Spud 8-8-53
D & A
TD 3298'
8" @ 187'
Top 2504, Heeb 2773, Tor 2792,
Br. Lime 2893, Lans 2916, Cong 3252
Arb 3283
TD 3298'
D & A

ABANDONED

County Rice State Kansas

Sec. 1 (Blk. Twp.) 19 (Sur. Rge.) 10W Map No.

Operator Rex & Morris

Well No. 1 Farm Behnke

Elev. _____ Location SE SW NE

330 Ft. From S Line NE

990 Ft. From W Line Quarter

1st. Report 4UG 5 1953

Completion _____


Remarks _____

Spudding Date _____

Drig. Data Chase-Silica Pool

Location _____

County Rice State Kansas
 Sec. 1 (Blk. 1 Twp.) 19 (Sur. 10W Rge.) Map No.
 Operator Rex & Morris
 Well No. 1 Farm Behnke
 Elev. 1723 Location SE SW NE

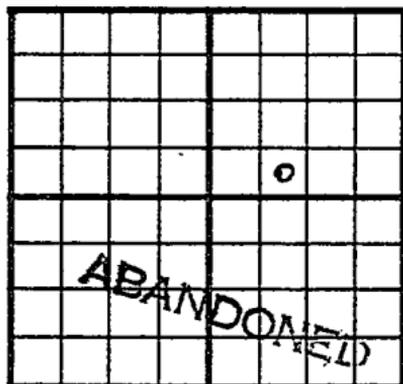

330 Ft. From S Line NE
990 Ft. From W Line Quarter

1st. Report

Completion AUG 19 1953

Remarks Chase-Silica Pool

Spudding Date 8-8-53

Drig. Data D & A TD 3298

8" @ 187 Top. 2504 Heeb. 2773.

Tor. 2792 Br. lime. 2893 Lans. 2916

Cong. 3252 Arb. 3283 TD 3298

D & A

J. G. MCGEEHEE