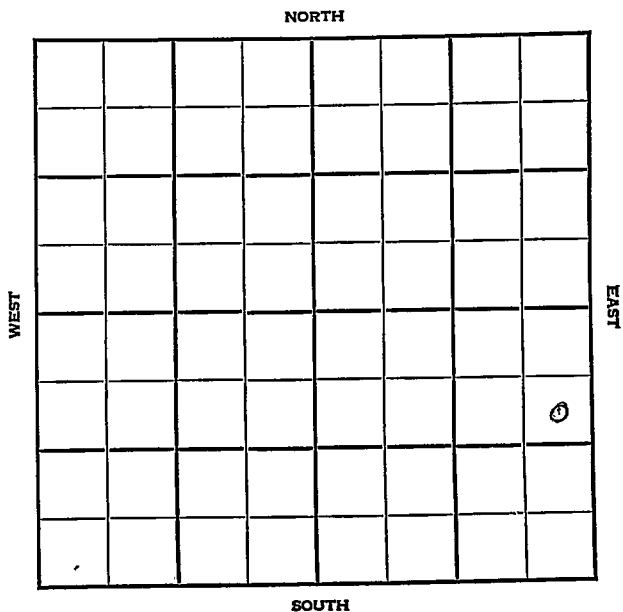


Section 1 Township 19 Range 10Well No. #2 BehnkeCompany Cities Service

KANSAS

Rice

Sec. 1 Twp. 19 R. 10-W

Well No. #2 Behnke Farm

Cities Service

Company

Silica Pool


990' Ft. from N. Line

Ft. from S. Line

300' Ft. from E. Line

Ft. from W. Line

SE NE SE

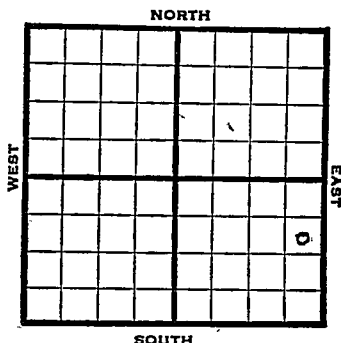

1947	Elev. 1717' REPORT
11/25	Location
12/3	"
12/10	8" @ 262' Drlg. 2300'
12/17	Lansing 2887' Arbuckle 3251' TD 3254' 5" @ 3252' RUST
12/30	"
1948 1/7	Arbuckle 3245' corrected 5" @ 3246' TD 3254' 48 shots 2956-67' - 500 acid Flow 67 bbls. oil in 3 hrs.
1/14	Flow 324 bbls oil 13 hrs No water
1/21	Arb. 3245' 5" @ 3246' Lans. 2887' Perf. Lans. 500 acid Bonus Pot 1071 oil / 1% W 42.0 Gr. TD 3254' Comp.
COMPLETED	

Map No. _____ Sec. 1 Twp. 19 R. 10W

Well No. 2 Behnke

Cities Service Company

FIRST REPORT

Contractor

SE NE SE


SECTION PLAT

990 Ft. from N. Line

_____ Ft. from S. Line

330 Ft. from E. Line

_____ Ft. from W. Line

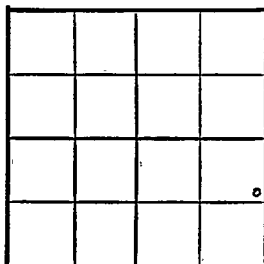

Rice County

Location X

Rig up _____

Drilling and Remarks:

RECORD

Cased _____ in., _____ ft.

Sand _____

Gas _____

Oil _____

Total Depth _____

PRODUCTION

1st 24 hrs. Nat. _____

1st 24 hrs. after shot _____

Gas _____ Cu. Ft.

Dry Hole _____

Abandoned _____

Date

NOV 25 1947 19 _____ S. J. LEWIS Scout

Map No. 46 Sec. 1 Twp. 19 R. 10W

Well No. 2 Behnke

Cities Service Company

COMPLETE

Contractor

SE NE SE


E111717
SECTION PLAT

990 Ft. from N. Line

 Ft. from S. Line

330 Ft. from E. Line

 Ft. from W. Line

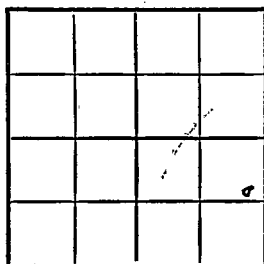

Rice County

Location

Rig up

Drilling and Remarks:

Cor 3245
5~103246
lane 2887
Prof lane.
5' acid
Arm 1071 oil
7100W 42.2 lb

RECORD

Cased in., ft.

Sand

Gas

Oil ✓

Total Depth 3254

PRODUCTION

1st 24 hrs. Nat.

1st 24 hrs. after shot

Gas Cu. Ft.

Dry Hole

Abandoned

Date

JAN 21 1948

19

S. J. LEWIS Scout