


FORM 51-5M PETROL

Section 1 Township 19 Range 2W

Well No. 1 Russell "A"

Company Derby Oil

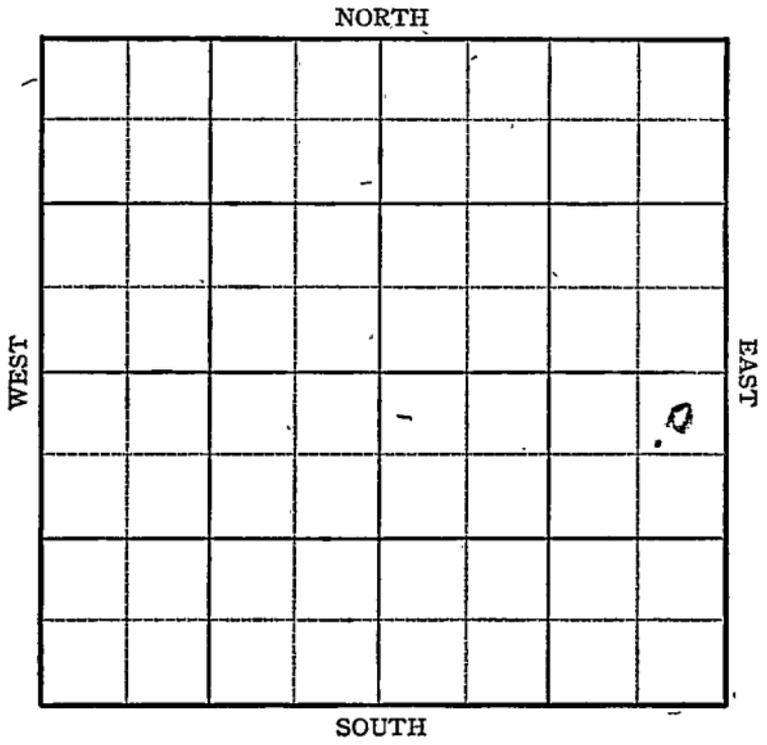

Sec. 1 Twp. 19 R. 2W

Well No. #1 Russell "A" Farm _____

Derby Oil Company _____


Jenday

330 Ft. from N. Line

_____ Ft. from S. Line

330 Ft. from E. Line

_____ Ft. from W. Line

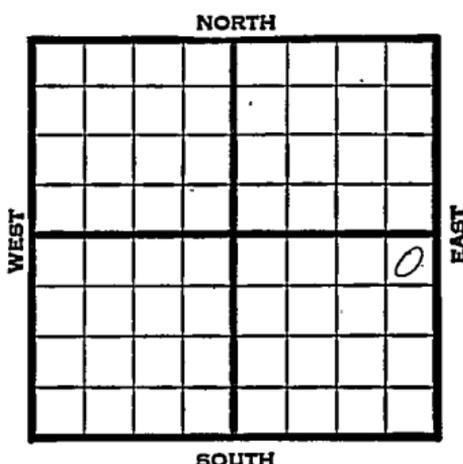

NE SE

1945 Elev. 1571 REPORT

7/11 8" @ 153
Drlg. 2398

7/19 Miss. 2952-2958
TD 2958
5" @ 2954' RUST

7/26 Drlg. 2976

8/15 Miss. 2952
5" @ 2954
1000 acid
TD 2976
Bomb Pot. 2296
Grav. 36.0

COMPLETED

KANSAS Kansas Pool Name Jenday

Map No. 43 Sec. 1 Twp. 19 R. 2W

Well No. 1 Russell "A"

Derby Oil Company

FIRST REPORT

Contractor

NE SE


SECTION PLAT

330 Ft. from N. Line

_____ Ft. from S. Line

330 Ft. from E. Line

_____ Ft. from W. Line

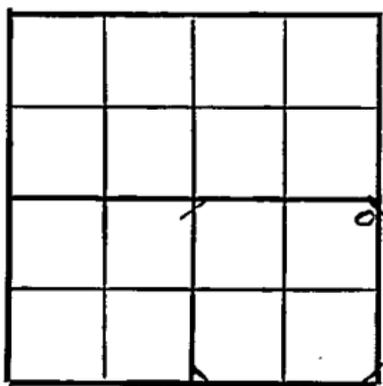

McPherson County

RECORD

Location _____

Rig up _____

Drilling and Remarks:

8"-153

2398

Cased _____ in., _____ ft.

Sand _____

Gas _____

Oil _____

Total Depth _____

PRODUCTION

1st 24 hrs. Nat. _____

1st 24 hrs. after shot _____

Gas _____ Cu. Ft.

Dry Hole _____

Abandoned _____

Date

JUL 11 1945 1945

S. J. LEWIS Scout

KANSAS

Kansas Pool Name JendayMap No. 43 Sec. 1 Twp. 19 R. 2WWell No. 1 Russell "A"Derby Oil Company**COMPLETED**

Contractor

NE SE

E. 1571

SECTION PLAT

330 Ft. from N. Line

_____ Ft. from S. Line

330 Ft. from E. Line

_____ Ft. from W. Line

			o

McPherson County

Location _____

Rig up _____

Drilling and Remarks:

Miss 2952
5" @ 2954
1000 sec/c
Bottom 72296

36 2/3

RECORD

Cased _____ in., _____ ft.

Sand _____

Gas _____

Oil _____

Total Depth 2976

PRODUCTION

1st 24 hrs. Nat. _____

1st 24 hrs. after shot _____

Gas _____ Cu. Ft.

Dry Hole _____

Abandoned _____

Date

AUG 15 1945 19S. J. LEWIS Scout