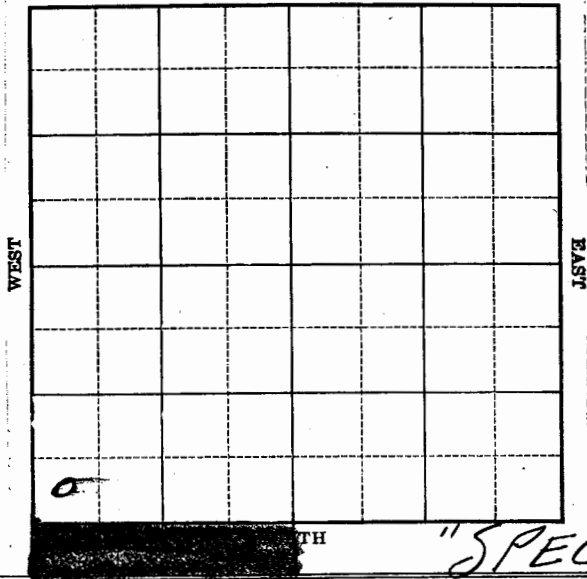


Map No. **KANSAS** Sec. 13 Twp. 19 R. 10WWell No. 1 Katterpohn Farm
James Davis Company

NORTH

Location
Drilling RemarksRig Up
Drilling Remarks

RECORD


Cased _____ in. _____ ft.
 Sand _____
 Gas _____
 Oil _____
 Total Depth _____

PRODUCTION

1st 24 hrs. Nat. _____
 1st 24 hrs. after shot _____
 Gas _____ cu. ft.
 Dry Hole _____
 Abandoned _____

Map No. **KANSAS** Sec. 13 Twp. 19 R. 10WWell No. 1 Katterpohn Farm
James Davis Company

NORTH

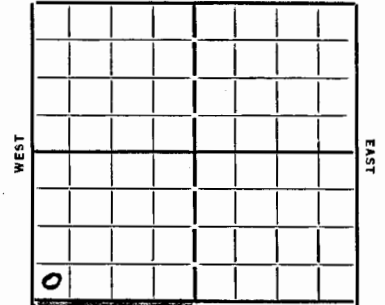

Ft. from N. Line

330 Ft. from S. Line

Ft. from E. Line

330 Ft. from W. Line"SPECIAL"

Date

1924
5/23 Location
5/31 Oldy. Rig
6/7 Rig
6/14 12" 427
6/21 10" 1212 57 Rep. brile
6/28 UR 10" 1705
7/5 dly 1905 (7/16 - Cong. 3260)
7/12 u.c. 8" 2460 s.o. 3295 219 Rep
7/19 dly 2900 8" 2452
7/27 Top Siliceous 3291
 5" 3291 TD 3314
 1000 feet oil in hole
 Will swell well this afternoon
 This is Siliceous lime
 formation & they may
 acidize later (2d)
7/28 Top Siliceous line 3291 TD 3314
 Swabbed 25 Bbls & swabbed
 down then let set 17 hrs.
 & swabbed 18 Bbls. showing trace
 of water 5" hanging 3298 Will
 cement 5" 46.6 hrs. Will acidize
 (2d)

Map No. 46 Sec. 13 Twp. 19 R. 10W
 Well No. 1-Katterjohn
James Davis Company
 Contractor

FIRST REPORTS

____ Ft. from N. Line
330 Ft. from S. Line
 ____ Ft. from E. Line
330 Ft. from W. Line

SPECIAL

SECTION PLAT

Location ✓

Rig up

Drilling and Remarks:

RECORD

Cased in in., ____ ft.
 Sand from
 Gas ____
 Oil ____
 Total Depth ____

PRODUCTION

1st 24 hrs. Nat. ____
 1st 24 hrs. after shot ____
 Gas ____ Cu. Ft.
 Dry Hole ____
 Abandoned ____

Date

5-23-34 19 ORVAL MANNSCHRECK Scout

Map No. 46 Sec. 13 Twp. 19 R. 10W
 Well No. 1-Katterjohn
James Davis Company
 Contractor

ABANDONED

SPECIAL

____ Ft. from N. Line
330 Ft. from S. Line
 ____ Ft. from E. Line
330 Ft. from W. Line

SECTION PLAT

Location

Rig up

Drilling and Remarks:

RECORD

Cased ____ in., ____ ft.
 Sand from 3291
 Gas ____
 Oil ____
 Total Depth 3338 1/2

PRODUCTION

1st 24 hrs. Nat. ____
 1st 24 hrs. after shot ____
 Gas ____ Cu. Ft.
 Dry Hole ____
 Abandoned ____

Date

8-22-34 19 O. M. Manschreck Scout