


Section 10 Township 19 Range 12W

Well No. #1 Scharzt

Company J. C. Dozier

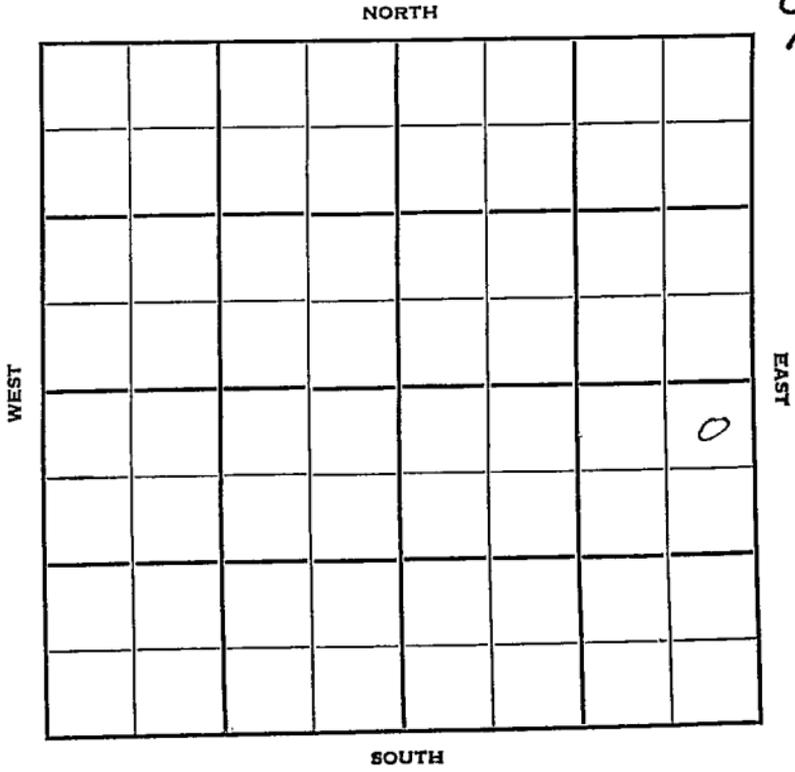

Sec. 10 Twp. 19 R. 12W

Well No. #1 Scharz Farm

J. C. Dozier Company

Lewis Drlg. Contractor


Wildcat

330' Ft. from N. Line

_____ Ft. from S. Line

330' Ft. from E. Line

_____ Ft. from W. Line

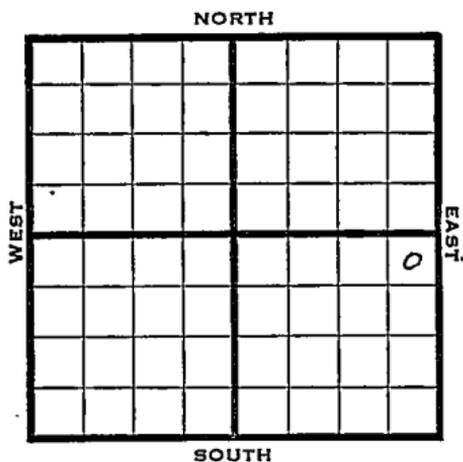

NE NE SE

1950 Elev 1824' REPORT

2/8 RUR
 4/5 TD 3405'
 8" @ 253'
 5 1/2" set 3395'
 Lans 3122'
 Cong 3393'
 P .54 BOPD in Cong
 Comp

COMPLETED

Map No. _____ Sec. 10 Twp. 19 R. 12W

Well No. 1 Schartz

J. C. Dozier _____ Company

Lewis Drlg. _____ Contractor

NE NE SE


330 Ft. from N. Line

_____ Ft. from S. Line

330 Ft. from E. Line

_____ Ft. from W. Line

SECTION PLAT

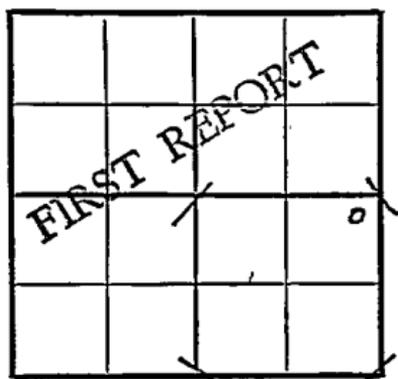

Barton County

Location _____

Rig up _____

Drilling and Remarks: _____

R U R

RECORD

Cased _____ in., _____ ft.

Sand _____

Gas _____

Oil _____

Total Depth _____

PRODUCTION

1st 24 hrs. Nat. _____

1st 24 hrs. after shot _____

Gas _____ Cu. Ft.

Dry Hole _____

Abandoned _____

Date

FEB 8 1950₁₉

J. E. TYRA Scout

Kansas

Map No. _____ Sec. 10 Twp. 19 R. 12W

Well No. 1 Schartz

J. C. Dozier Company

Contractor

NE NE SE


E. 1824
SECTION PLAT

330 Ft. from N. Line

_____ Ft. from S. Line

330 Ft. from E. Line

_____ Ft. from W. Line

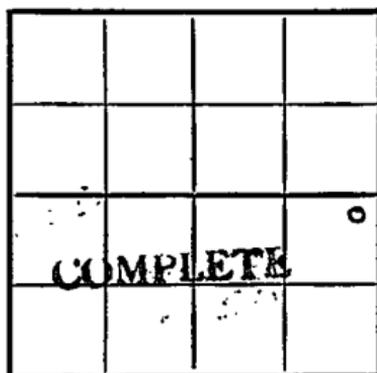

Barton County

Location _____

Rig up _____

Drilling and Remarks:

8" @ 253
5 1/2" @ 3395
Lans 3122
cong 3393
P 54 BOPD
in cong.

RECORD

Cased _____ in., _____ ft.

Sand _____

Gas _____

Oil _____

Total Depth 3405

PRODUCTION

1st 24 hrs. Nat. _____

1st 24 hrs. after shot _____

Gas _____ Cu. Ft.

Dry Hole _____

Abandoned _____

Date

APR 5 1950

19

J. E. TYRA

Scout