


Section 10 Township 19 Range 12 W

Well No. # 1 Weiss

Company Lewis Drlg.

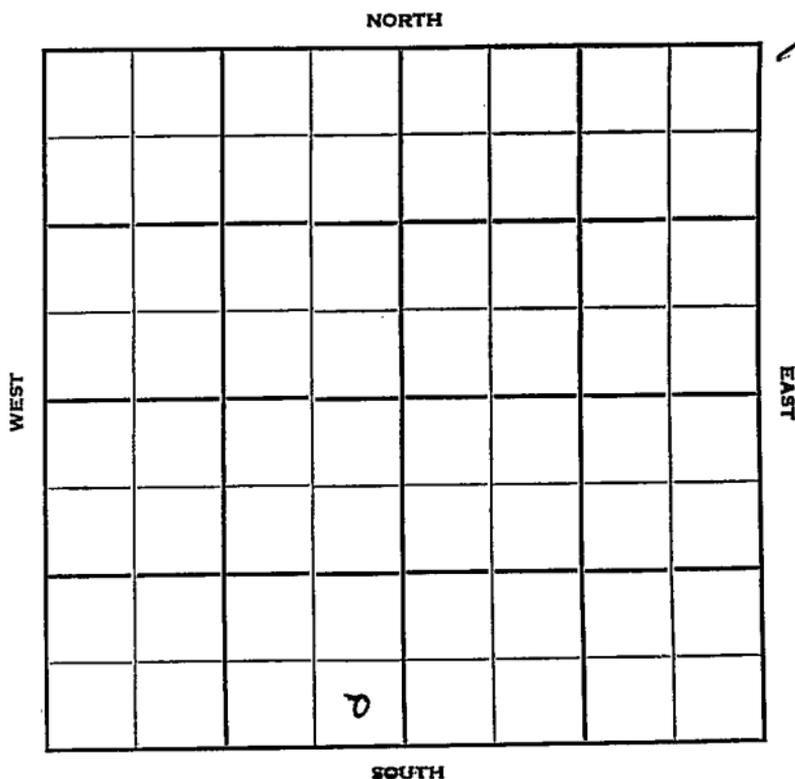

Barton

KANSAS

Sec. 10 Twp. 19 R. 12W 1

Well No. #1 Weiss Farm

Lewis Drlg. Company

Lewis Drlg. - Contr. Contractor

North Hammer Pool


 Ft. from N. Line

330' Ft. from S. Line

330' Ft. from E. Line

 Ft. from W. Line

SE SE SW

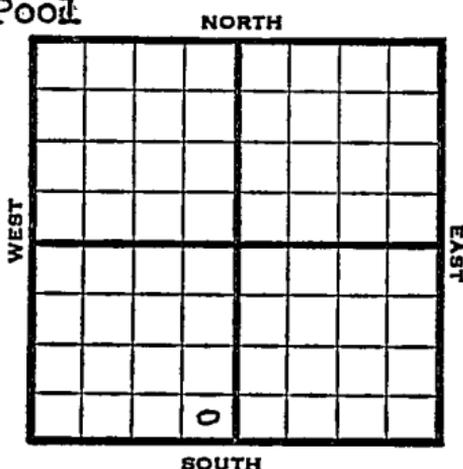

1951 Elev. 1840' REPORT

2/21 Spud 2-12-51
8" @ 165
Anhy 655 -
Heeb. 3016
Br Line 3130
Lans. 3144
Drlg. 3280'

5/9 Spud 2-12-51 D & A TD 3475'
8" @ 165' Anhy 655' Heeb 3016'
Br. line 3130' Lans. 3144'
5" @ 3410' 18/3410-32
B/1/2 BOPH Arb. 3462-75' TD
P/ 3 BOPD & water
D & A

ABANDONED

