


Section 10 Township 19 Range 12W

Well No. #1 Wess

Company Alpine Oil & Royalty

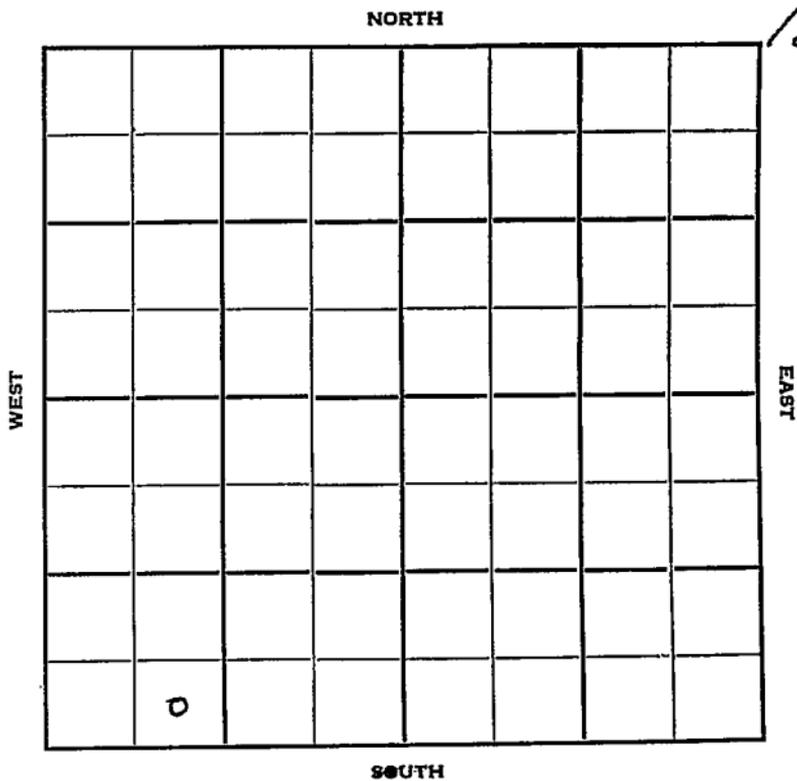

Sec. 10 Twp. 19 R. 12W ✓

Well No. #1 Wess Farm

Alphine Oil & Royalty Company

Contractor

Cheyenne View Pool

NORTH


Ft. from N. Line

330' Ft. from S. Line

Ft. from E. Line

990' Ft. from W. Line

SE SW SW

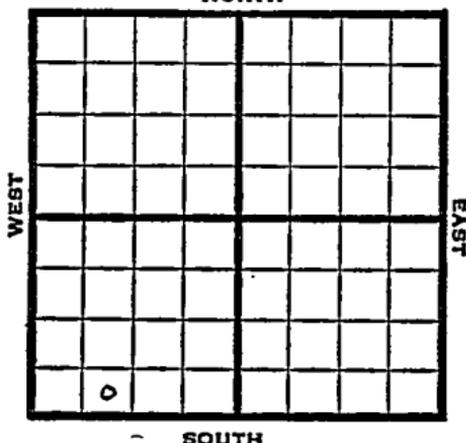

1950 Elev. 1839' REPORT

12/6 Spud 12-2-50

12/13 Spud 12-2-50  
D&A TD 3441  
8" @ 228' Anhy 660-90  
Heeb. 3016' Br. Lime 3128  
Lans. 3144'  
DST 3147-3222 opn 1 hr Rec. 360'  
mud & sw Cong. 3417  
DST 3392-3427 opn 1 hr Rec. 30' mud  
TD 3441' D&A

**ABANDONED**



