


Section 10 Township 19 Range 12-W

Well No. #1 Bryant

Company J C Dozier

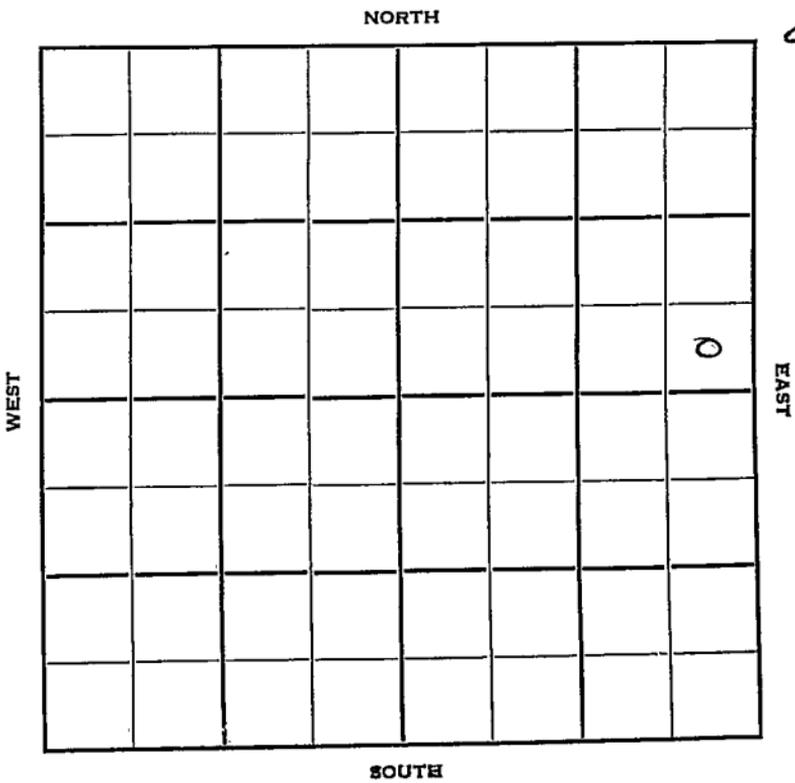

Sec. 10 Twp. 19 R. 12W

Well No. #1 Bryant Farm

J. C. Dozier Company

Lewis Contractor

Cheyenne View Pool


_____ Ft. from N. Line

330' Ft. from S. Line

330' Ft. from E. Line

_____ Ft. from W. Line

SE SE NE

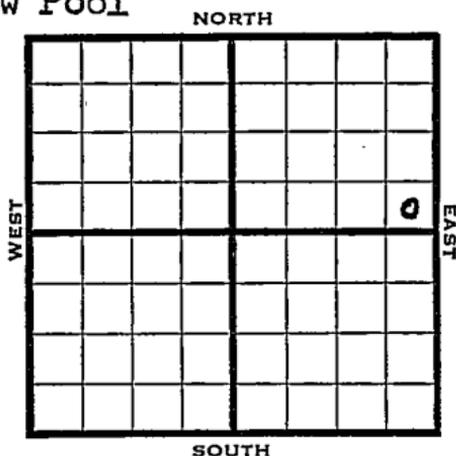

1950

Elev 1827 REPORT

8/16 MIM

10/4 Spud 8-15-50

8" @ 125

Top 2735

Heeb 2990

Br line 3112

Lans 3125

DST 3113-3200 opn 1 hr rec 290' socm

DST 3255-3330 opn 1 hr rec 530' o&gcm

Cong 3398

TD 3408

DST 3398-3408 opn 1 hr rec 600' oil

5" @ 3398

perf 3360-70 10 boph

Comp 260 bopd

Completed

COMPLETED

County Barton State Kansas

Sec. 10 (Blk. Twp.) 19 (Sur. Rge.) 12W Map No.

Operator J. C. Dozier

Well No. 1 Farm Bryant

Elev. _____ Location SE SE NE

330 Ft. From S Line NE

330 Ft. From E Line Quarter

1st. Report AUG 16 1950

Completion _____


Remarks _____

Stanolind farmout

Spudding Date _____

Drlg. Data Cheyenne View Pool

MEM

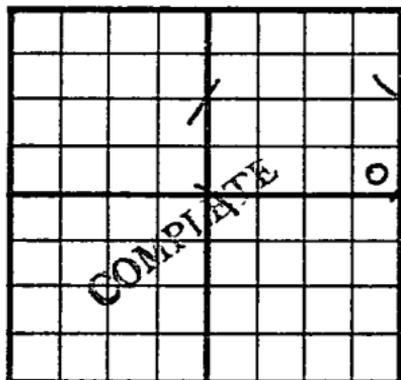County Barton State KansasSec. 10 (Blk.
Twp.) 19 (Sur.
Rge.) 12W Map No.Operator J. C. DozierWell No. 1 Farm BryantElev. 1827 Location SE SE NE330 Ft. From S Line NE330 Ft. From E Line Quarter1st. ReportCompletion OCT 4 1950Remarks Cheyenne View PoolLewis Drlg. - Contr.Spudding Date 8-15-50Drlg. Data Oil well TD 34088" @ 125 Top. 2735 Heeb. 2990Br. lime 3112 Lans. 3125 DST 3113-3200open 1 hr. Rec. 290' socm DST 3255-3330open 1 hr. Rec. 530' o & gcm Cong. 3398TD 3408 DST 3398-3408 open 1 hr.Rec. 600' oil 5" @ 3398 Perf. 3360-7010 boph Comp. 260 bopd

J. E. TYRA