

Sec. 10 Twp. 19 R. 12-W

Well No. #2 Schartz Farm

Dozier Oil Company

Contractor

North Hammer


Ft. from N. Line

330 Ft. from S. Line

Ft. from E. Line

330 Ft. from W. Line

SW SW SE

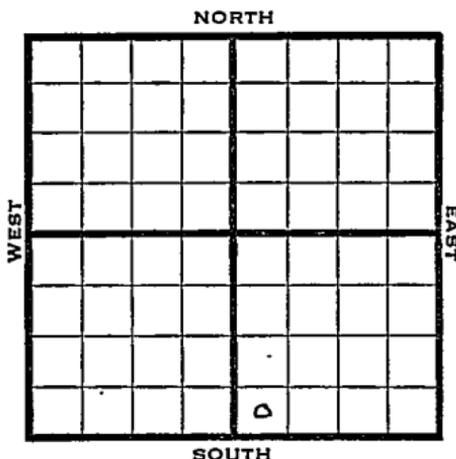

1950

Elev 1838

REPORT

8/30 Spud 8-29-50
Drlg

9/13 8" @ 143

Anhy 686

Lans 3140

DST 3144-3226 op 1 hr rec 95' socm

DST 3275-60 op 1 hr rec 180' ocm

Cong 3406

DST 3407-23 op 1 hr rec 8' mud

T^U 3460

D&A

ABANDONED

