


Section 10 Township 19 Range 11W

Well No. #2 Misenberg "B"

Company G. E. Ash

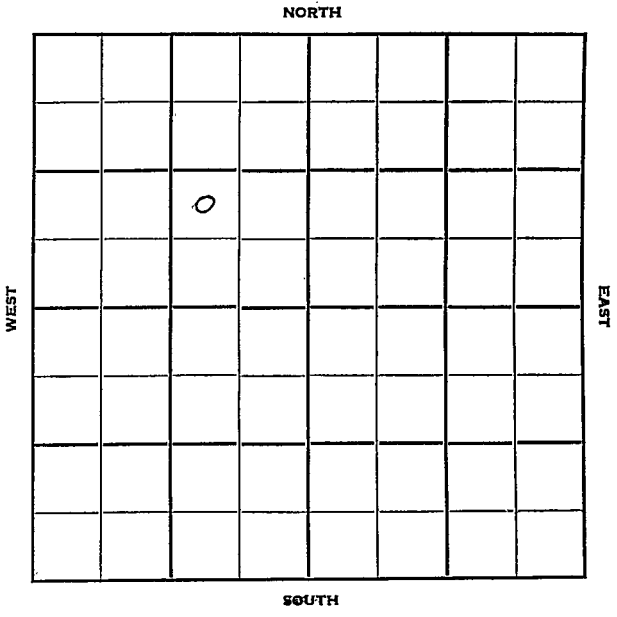

Barton KANSAS

Sec. 10 Twp. 19 R. 11 W

Well No. # 2 Musenberg ^{WB} Farm

C. E. Ash Company

Ash Contractor

Bernard Pool


Ft. from N. Line

990 Ft. from S. Line

990 Ft. from E. Line

Ft. from W. Line

NW SE NW

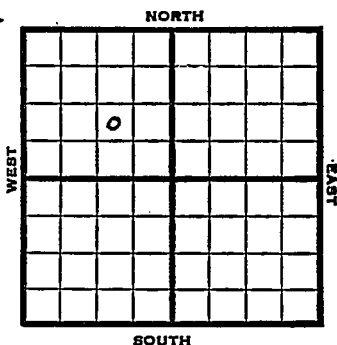

1951

Elev. 1781'

REPORT

3/14

Spud 3-6-51

8" @ 328'

Anhy 565'

Drlg. 2525'

5/2

Spud 3-6-51

Oil well TD 3374'

8" @ 328 Anhy 565' Top 2649'

Heeb 2915' Dodge 2933' Br. lime

3033', Lans. 3052'

DST 3133-45 open 15 min. rec 150' oil, 100' OCM,

DST 3226-42 open 1 hr. rec 90' SOCM

Cong. 3372' 5" @ 3297' SP 3247'

24/3226-32 500 A

Comp. 319 BOPD 10% water

COMPLETED

County Barton State KansasSec. 10 (Blk. Twp.) 19 (Sur. Rge.) 11W Map No. _____Operator C. E. AshWell No. 2 Farm Musenberg "B"Elev. _____ Location NW SE NW

FIRST REPORT


990 Ft. From S Line NW990 Ft. From E Line Quarter1st. Report MAR 14 1951

Completion _____

Remarks _____

Ash - Contr.Spudding Date 3-6-51Drlg. Data Bernard Pool8" @ 328 Anhy 565 drlg. 2525

J. E. TYRA

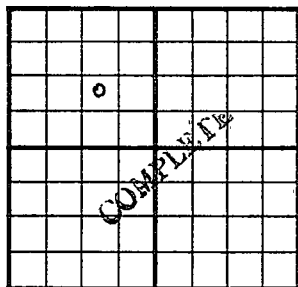County Barton State KansasSec. 10 (Blk.
Twp.) 19 (Sur.
Rge.) 11W Map No.Operator C. E. AshWell No. 2 Farm Musenberg "B"Elev. 1781 Location NW SE NW990 Ft. From S Line NW990 Ft. From E Line QuarterIst. ReportCompletion MAY 2 1951Remarks Bernard PoolAsh - Contr.Spudding Date 3-6-51Drlg. Data Oil well TD 33748" @ 328 Anhy 565 Top. 2649Heeb. 2915 Dodge 2933 Br. lime 3033Lans. 3052 DST 3133-45 open 15 min.Rec. 150' oil 100' ocm DST 3226-42open 1 hr. Rec. 90' socm Cong. 33725" @ 3297 SP 3247 24/ 3226-32 500 AComp. 319 hpd 10% water

J. E. TYRA