


Section 10 Township 19 Range 11WWell No. 5 Musenberg "B"Company C. E. Ash

NORTH

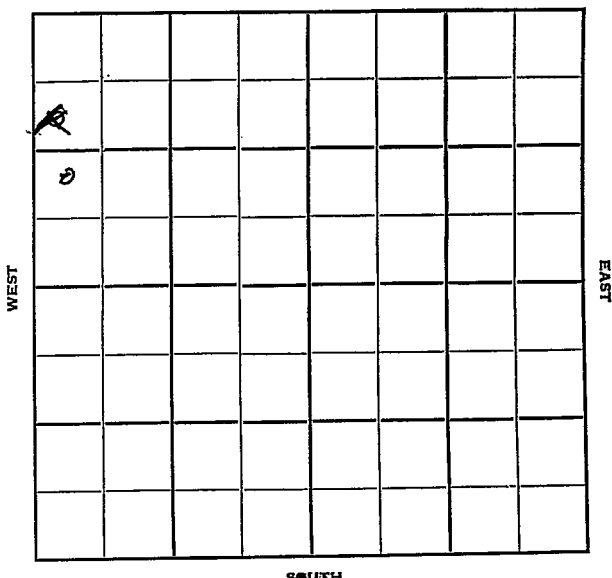

Barton **KANSAS**
19 11W

Sec. 10 Twp. 19 R. 11W

Well No. #5 Musenberg "B" Farm

C. E. Ash- Company

Ash - Contr. Contractor
Bernard Pool


 Ft. from N. Line

990' Ft. from S. Line

 Ft. from E. Line

330' Ft. from W. Line

NW SW NW

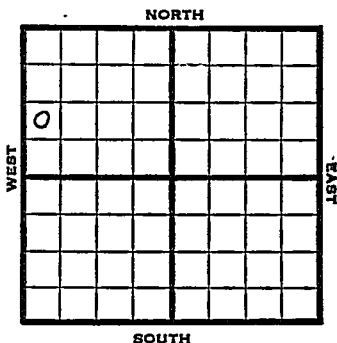

1951 Elev. 1774' REPORT

7/18
8/1

RUR

Spud 7-17-51
D&A TD 3426
8" @ 322
Anhy 545 Top. 2652
Heeb. 2923 Dodge 2942
Br Lime 3042 Lans. 3061
DST 3082-94 opn $\frac{1}{2}$ hr
Rec. 30' mud SSO & gas
DST 3194-3212 opn 20 min.
Rec. 8' mud Sd. Cong. 3349
Ch Cong. 3368 Arb. 3378
DST 3381-97 opn 20 min.
Rec. 6' mud TD 3426 D&A

ABANDONED

County Barton State KansasSec. 10 (Blk. Twp.) 19 (Sur. Rge.) 11W Map No.Operator C. E. AshWell No. 5 Farm Musenberg "B"Elev. Location NW SW NW

0							

990 Ft. From S Line NW330 Ft. From W Line Quarter1st. Report JUL 1 8 1951

Completion


Remarks

Ash - Contr.

Spudding Date

Drlg. Data Bernard PoolR U R

County Barton State Kansas
 Sec. 10 (Blk. 19) (Sur. 11W) Map No. 11W
 Operator C. E. Ash
 Well No. 5 Farm Musenberg "B"
 Elev. 1774 Location NW SW NW

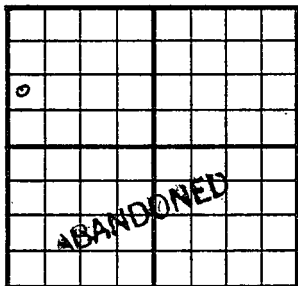

990 Ft. From S Line NW
330 Ft. From W Line Quarter
 1st. Report
 Completion AUG 1 1951
 Remarks Bernard Pool
Ash - Contr.
 Spudding Date 7-17-51

Drlg. Data D & A TD 3426
8" @ 322 Anhy 545 Top. 2652
Heeb. 2923 Dodge 2942 Br. lime 3042
Lans. 3061 DST 3082-94 open $\frac{1}{2}$ hr.
Rec. 30' mud SSO & gas DST 3194-3212
open 20 min. Rec. 8' mud Sd. cong. 3349
ch. Cong. 3368 Arb. 3378 DST 3381-97
open 20 min. Rec. 6' mud TD 3426
D & A

J. E. TYRA