
FORM 51 25M 8-50 WESTERN Barton KANSAS

Section 10 Township 19 Range 11W

Well No. #3 Birzer (B)

Company C. E. Ash

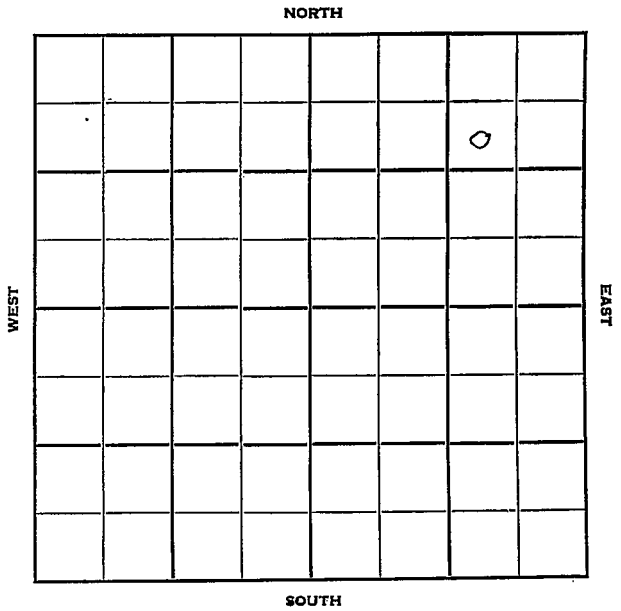

FORM 252-B
10M 10-50 PETROL

Barton KANSAS

Sec. 10 Twp. 19 R. 11W

Well No. #3 Birzer (B) Farm

C. E. Ash Company

Ash-Contr. Contractor

Klepper


990' Ft. from N. Line

Ft. from S. Line

990' Ft. from E. Line

Ft. from W. Line

SW NE NE

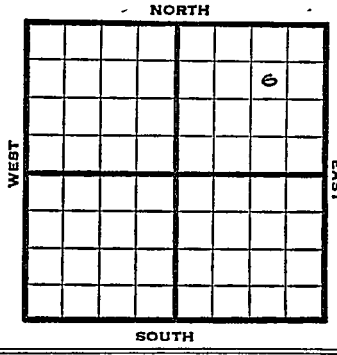

1952	Elev. 1774' REPORT
1/23	RUR
2/6	Spud 1-22-52 D&A TD 3398 8" @ 330' Anhy 558 Top 2645 Heeb. 2913 Dodge 2936 Br lime 3030 Lans. 3049 DST 3183-97 opn 1/2 hrs Rec. 10' vsocm DST 3221-31 opn ½ hr Rec. 5' mud Cong. 3357 Cherty Cong. 3371 Arb. 3394 TD 3398 D&A **ABANDONED**

FORM 275 FOR SALE BY KANSAS BLUE PRINT CO.


County Barton State Kansas

Sec. 10 (Blk. Twp.) 19 (Sur. Rge.) 11W Map No.

Operator C. E. Ash

Well No. 3 Farm Birzer (B)

Elev. Location SW NE NE

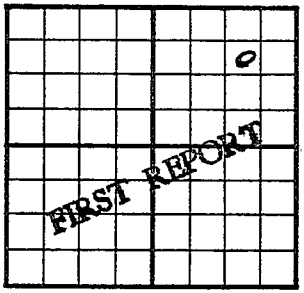

990 Ft. From N Line NE

990 Ft. From E Line Quarter

1st. Report JAN 2 3 1952

Completion

Remarks

Ash - Contr.

Spudding Date

Drlg. Data Klepper

RUR

J. E. TYRA

FORM 275 FOR SALE BY KANSAS BLUE PRINT CO.


County Barton State Kansas

Sec. 10 (Blk. Twp.) 19 (Sur. Rge.) 11W Map No.

Operator C. E. Ash

Well No. 3 Farm Birzer "B"

Elev. 1774 Location SW NE NE

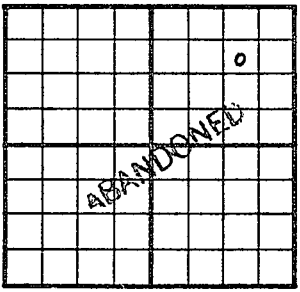

990 Ft. From N Line NE

990 Ft. From E Line Quarter

1st. Report

Completion FEB 6 1952

Remarks Klepper Pool
Ash - Contr.

Spudding Date 1-22-52

Drlg. Data D & A TD 3398

8" @ 330 Anhy 558 Top. 2645

Heeb. 2913 Dodge 2936 Br. lime 3030

Lans. 3049 DST 3183-97 open ½ hr.

Rec. 10' vsocm DST 3221-31 open ½ hr.

Rec. 5' mud Cong. 3357 Cherty Cong. 3371

Arb. 3394 TD 3398

D & A

J. G. McGEHEE