
FORM 51 25M 8-50 WESTERN Barton

KANSAS

Section 10 Township 19 Range 11W

Well No. #4 Birzer (B)

Company C. E. Ash

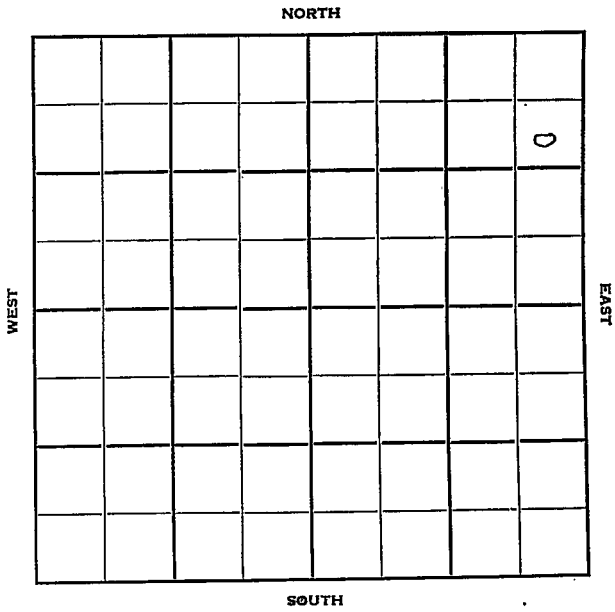

FORM 252-B
10M 8-51 TPCO.

KANSAS

Barton

Sec. 10 Twp. 19 R. 11W

Well No. #4 Birzer (B) Farm

C. E. Ash Company

Contractor

Barnard


990 Ft. from N. Line

Ft. from S. Line

330 Ft. from E. Line

Ft. from W. Line

SE NE NE

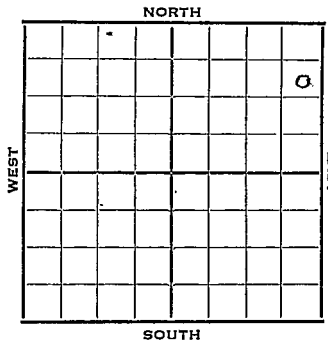

1952	Elev. 1774' REPORT
3/5	Pits
3/11	"
3/19	8" @ 340' Anhy 560' Drlg. 2139'
3/25	Topeka 3644' DST 2854-72, 1 hr, 140' M & wtr. 1000# Heeb 2912' Br Li 3029' KC 3048' DST 3182-98, 45 mins, 65' O & GCM, 690#. DST 3217-29, 45 mins, 22' SO & GCM, Cong. 3350-53' RTD 5" @ 3283' WOCT
4/1	WOCT
4/9	PB 3248 24/3182-90 1000A
4/23	Est 40 BOPD
4/30	NR
5/7	NR
5/14	"
5/21	"
5/28	"
6/11	Spud 3-13-52 Oil Well TD 3353' 8" @ 340' Anhy 560 Top. 2644 DST 2854-72 open 1 hr. rec. 140' mud & wtr.

OVER

1952

6/11 Heeb. 2912 Br Li 3029
KC 3048
DST 3182-98 open 45 min. rec. 65' o&gcm
DST 3217-29 open 45 min. rec. 22' so & gcm Cong. 3350
5" @ 3283 PB 3248 24/ 3182-90
1000 A 3 boph 3000 A 11 boph
oil dec. Comp. 119 bopd

COMPLETED

FORM 275 FOR SALE BY KANSAS BLUE PRINT CO.


County Barton State Kansas

Sec. 10 (Blk. / Twp.) 19 (Sur. / Rge.) 11W Map No.

Operator C. E. Ash

Well No. 4 Farm Birzer (B)

Elev. Location SE NE NE

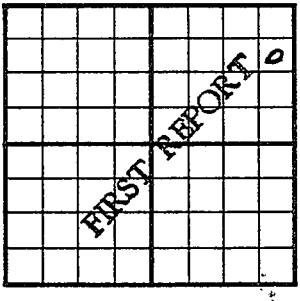

990 Ft. From N Line NE

330 Ft. From E Line Quarter

1st. Report MAR 5 1952

Completion

Remarks

Spudding Date

Drlg. Data Barnard

Pits

J. G. McGEHEE

Scout Cards .....
Land Small Map .....
Land Wall Map .....
Tracings .....
France Map .....
Pierce Map .....
Misc. .....

MAR 7 1952

Drlg. Data

FORM 275 FOR SALE BY KANSAS BLUE PRINT CO


County Barton State Kansas

Sec. 10 (Blk. Twp.) 19 (Sur. Rge.) 11W Map No.

Operator C. E. Ash

Well No. 4 Farm Birzer "B"

Elev. 1774 Location SE NE NE

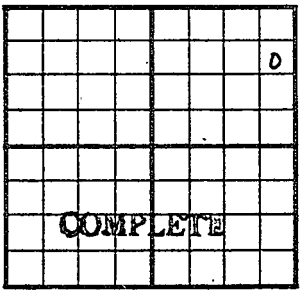

990 Ft. From N Line NE

330 Ft. From E Line Quarter

1st. Report

Completion JUN 11 1952

Remarks Barnard Pool

Spudding Date 3-13-52

Drlg. Data Oil well TD 3353

8" @ 340 Anhy 560 Top. 2644

DST 2854-72 open 1 hr. Rec. 140' mud & water Heeb. 2912 Br. lime 3029

KC 3048 DST 3182-98 open 45 min.

Rec. 65' o & gcm DST 3217-29

open 45 min. Rec. 22' so & gcm

Cong. 3350 5" @ 3283 PB 3248

24/ 3182-90 1000 A 3 boph 3000 A

11 boph oil dec.

Comp. 119bopd

J. G. McGEHEE

Scout Cards .....
Land Small Map .....
Land Wall Map .....
Tracings .....
France Map .....
Pierce Map .....
Misc. .....

JUN 18 1952

Drlg. Data