


Section 10 Township 19 Range 11W

Well No. #8 Musenberg (B)

Company C. E. Ash et al

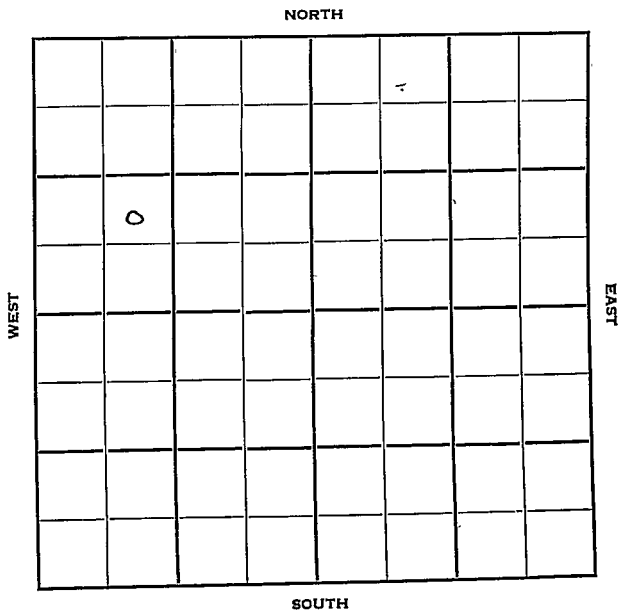

Barton

Sec. 10 Twp. 19 R. 13W ✓

Well No. #8 Musenberg (B) Farm

C. E. Ash et al Company

C. E. Ash - Contr. Contractor

Bernard Pool


 Ft. from N. Line

990' Ft. from S. Line

 Ft. from E. Line

990' Ft. from W. Line

NE SW NW

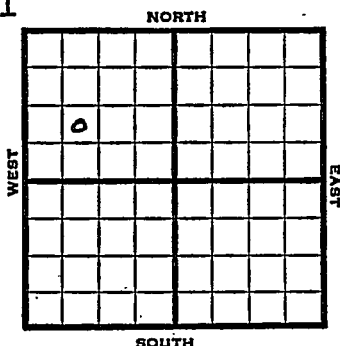

1951


Elev. 1777' REPORT

9/19 Spud 9-16-51
8" @ 323

10/17 Spud 9-16-51
Oil Well TD 3385
8" @ 323
Top 2647 Heeb. 2915
Br Line 3032 Lans. 3052
DST 3070-82opn 25 min.
Rec. 2,930,000 gas 120' ho & gcm
DST 3130-48 opn 50 min.
Rec. 145' so & gcm
DST 3193-3202 opn 1 hr Rec. 58' mud
& sw DST 3226-38 opn 20 min.
Rec. 10' mud Cong. 3371
Arb. 3381-85 5" @ 3151
24/3180-85 1000 A Comp. 309 bopd

COMPLETED

County Barton State Kansas
 Sec. 10 (Blk.) 19 (Sur.) 11W Map No.
 Operator C. E. Ash et al.
 Well No. 8 Farm Musenbergl "B"
 Elev. 1777 Location NE SW NW

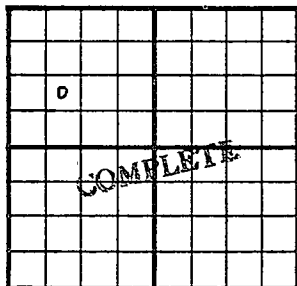

990 Ft. From S Line NW
990 Ft. From W Line Quarter
 Ist. Report
 Completion OCT 17 1951
 Remarks Bernard Pool
Ash - Contr.
 Spudding Date 9-16-51

Drlg. Data Oil well TD 3385
8" @ 323 Top. 2647 Heeb. 2915
Br. lime 3032 Lans. 3052 DST 3070-82
open 25 min. Rec. 2,930,000 gas 120' ho
& gcm DST 3130-48 open 50 min.
Rec. 145' so & gcm DST 3193-3202
open 1 hr. Rec. 58' mud & sw DST 3226-
38 open 20 min. Rec. 10' mud
Cong. 3371 Arb. 3381-85 5" @ 3151
24/ 3180-85 1000 A Comp. 309 bopd

J. E. TYRA