


Barton

KANSAS

SECTION 10 TOWNSHIP 19 RANGE 11 W

WELL NO. #9 Musenberg "B"

COMPANY C. E. Ash & Graybol

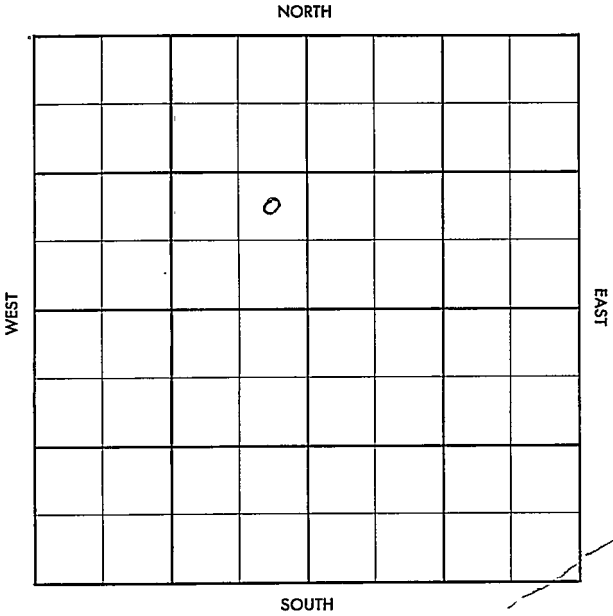

Barton

KANSAS

SEC. 10	TWP. 19	R. 11W
------------	------------	-----------

WELL NO.

#9 Musenberg "B"

FARM

COMPANY

C.E. Ash & Graybol

CONTRACTOR

Bea Tools

Bernard


Ft. from N. Line

Ft. from S. Line

Ft. from E. Line

Ft. from W. Line

NE SE NW

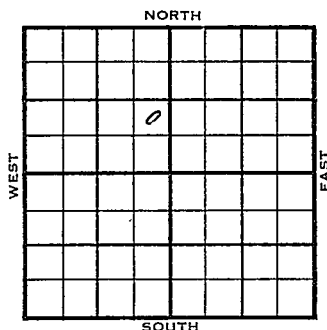

1955

ELEVATION
1777'

REPORT

12-7

MIR

1956

1-11

Comm. 12-6-55

8 5/8" @ 324/165

DST 3074-92 op 1 hr. rec. 35' gcm,
580/20"DST 3132-45 op 1 hr. rec. 155' so&gcm
840#

DST 3192-3207 op 1 hr. rec. 15' mud, 9#

DST 3219-35 op 45 min. rec. 10' mud, 0#
5 1/2" @ 3200

CO 24/ 3139-45, 500 A

S/ wtr.,

PB 3120, 36/ 2866-72, 1000 A

HFW

Temp. abd.

Tp. 2649

H. 2917

Tr. 2939

BL. 3035

L. 3053

BKG 3309

Cherty 3341

Cg. sd. 3345

TD 3363'

ABANDONED

County Barton Elev. _____
 Sec. 10 Twp. 19 Rge. 11W
 Company C. E. Ash & Graybol
 Farm Name Musenberg "B" No. 9

TOPS	DEPTH	LOG	DATUM	Loc. in Sec.
Anh.				NE SE NW
Tr.				
H.				
Tr.				
Dg.				
BL.				
L.				Geol.
K.C.				Contr.
B.K.C.				Bea tools
Ce.				Pool
C.				B ernard
M.				
M.				
K.				
Mz.				
Mo.				
V.				
S.				
S.				
A.				
R.				
Pe.				
G.				
T.D.				

FIRST REPORT
 DEC 7 '55

Date Comm.
 M I R

~~13~~

County Barton Elev. 1777
 Sec. 10 Twp. 19 Rge. 11W
 Company G. E. Ash & Graybol
 Farm Name Musenberg "B" No. 9

TOPS	DEPTH	LOG	DATUM	Loc. in Sec.
Anh.				NE SE NW
Tp.	2649		872	
H.	2915		1140	
Tr.	2939		1162	
Dg.				
Bl.	3135		1258	
L.	3053		1276	Geol.
K.C.				Contr.
B.K.C.	3319		1532	
Ce.				
C. <u>Chart.</u>	3341		1564	Bea tools
M. <u>Chart</u>	3345		1568	
M.				Pool
K.				Bernard
Mz.				
Ma.				
V.				
S.				
S.				
A.				
R.				
PE.				
G.				ABANDONED
T.D.	3363			

Date Comm. 12-6-55 JAN 1 1 1956
8 5/8" @ 324/165 DST 3074-92 open
1 hr. rec. 35' gcm 580/20" DST 3132-45 open 1 hr. rec. 155' so & gcm
840# DST 3192-3207 open 1 hr. rec. 15' mud 0# DST 3219-35 open 45 min.
rec. 10' mud 0# 5 1/2" @ 3200 CO
24/3139-45 500 A S/ wtr. PB 3120
36/ 2866-72 1000 A HFV
 Temp. abd.