


Section 10 Township 19 Range 11 W

Well No. # 4 Musenberg (D)

Company C. E. Ash

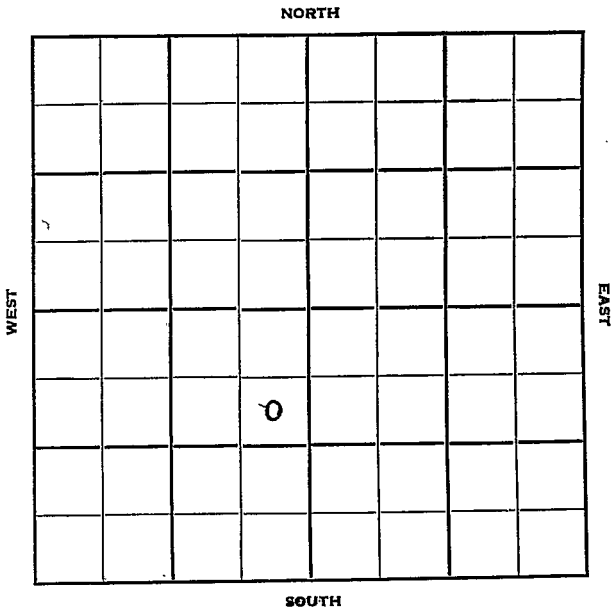

Sec. 10 Twp. 19 R. 11W

Well No. #4 Musenberg (D) Farm

C.E. Ash Company

Bernard Contractor


990' Ft. from N. Line

_____ Ft. from S. Line

330' Ft. from E. Line

_____ Ft. from W. Line

SE NE SW

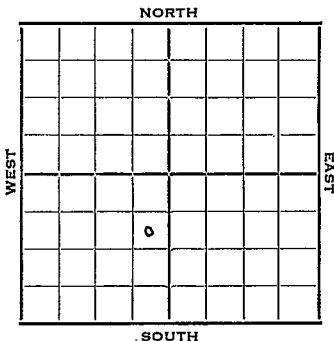

1951 Elev. 1773' REPORT

12/19 RUR

1952
1/30

Spud date 12-21-51
 Oil Well TD 3358
 8" @ 324' Anhy 550
 T. 2643 Heeb. 2913
 Dodge 2934 Br Lime 3032
 Lans. 3050
 DST 3132-44 opn 50 min.
 Rec. 30' wtr & mud DST 3182-94
 opn 35 min. Rec. 2600' gas 90' O&GCM
 DST 3219-29 opn 50 min.
 Rec. 660' gas 64' ho&gcm
 Cong. 3329 Arb. 3332
 TD 3358 5" @ 3283 22/3222-26
 S/2 3/4 boph 50% wtr 2000 A
 no inc. PB 3210 34/3188-94
 1000 A Est. 15 boph
 Comp. 223 bopd 4% wtr.

COMPLETED

