


Section 10 Township 19 Range 11W

Well No. #6 Musenberg (D)

Company C. E. Ash

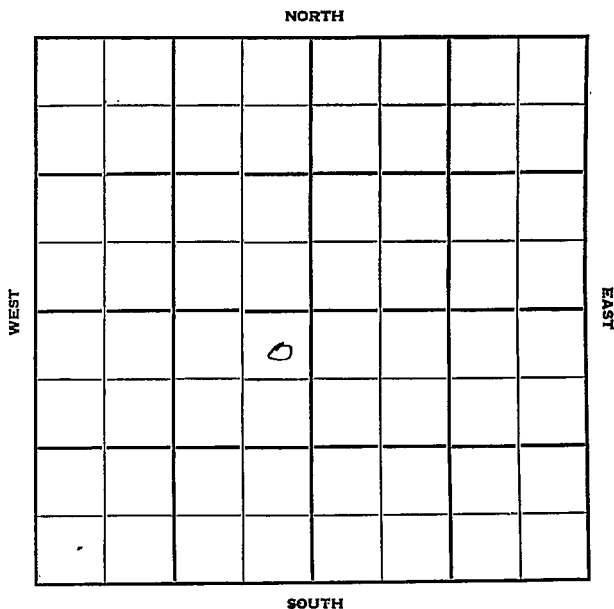

Sec. 10 Twp. 19 R. 11W

Well No. #6 Musenberg (D) Farm

C. E. Ash Company

Ash Contractor

Birnard


330 Ft. from N. Line

_____ Ft. from S. Line

330 Ft. from E. Line

_____ Ft. from W. Line

NE NE SW

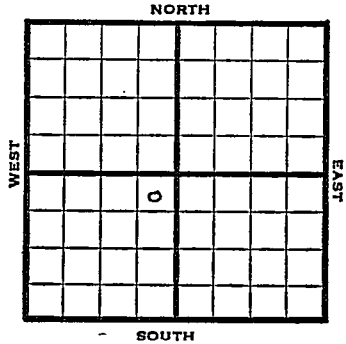

1952 Elev. 1774' REPORT

2/6 RUR
 2/13 Drlg. 2492'
 2/20 Topeka 2643' Heeb. 2909
 Br Li 3028 Lans. 3047
 DST 3178-92 3/4 hr. 360' gas 20' m.
 DST 3212-26 1 hr. 360' gas 30' SOCM
 Cong. 3328 Arb. 3343
 RTD 3389
 5" @ 3308'
 3/5 PB to ? 18/2866-72 S.O.
 1000 A S/10 BOPH for 8 hrs. POP
 3/11 NR
 3/19 F' 10 boph from Topeka
 3/26 Spud 2-6-52
 Oil Well TD 3389
 8" @ 324
 Anhy 550-80 Top. 2643
 Heeb. 2909 Br Li 3028
 Lans. 3047
 DST 3178-92 open 45 min.
 Rec. 360' gas 30' SOCM
 Cong. 3328 Arb. 3343
 TD 3389 5" @ 3308
 22/ 3213-20 1000 A SO 3000 A
 S/ 11 bo 11 bbl. acid wtr. 36 hr.
 PB ? 18/ 2866-72 1000 A

OVER

1952

3/26 S/ 10 boph 8 hr. F/ 10 boph
Comp. BHB 1437 bopd 10% wtr.

COMPLETED

County Barton State Kansas

Sec. 10 (Blk. Twp.) 19 (Sur. Rge.) 11W Map No.

Operator C. E. Ash

Well No. 6 Farm Musenberg (D)

Elev. _____ Location NE NE SW

FIRST REPORT

330 Ft. From N Line SW

330 Ft. From E Line _____ Quarter _____

Ist. Report FEB 6 1952

Completion _____

Remarks _____

Ash - Contr.

Spudding Date _____

Drlg. Data Birnard

RUR

J. G. McGEHEE

Cosut Cards *W*
1 Small Map
W. J. Wail Map *3*
.....
.....
France Map
Pierce Map
Misc.....

Orig. Date FEB 8 1952

Scout Cards	<i>Em.</i>
Land Small Map	
Land Wall Map	<i>33</i>
Tracings	
France Map	
Pierce Map	
Misc.	

APR 2 1952