
KANSAS

FORM 51 25M 8-50 WESTERN Barton

Section 10 Township 19 Range 11 W

Well No. # 7 Musenberg "D"

Company C. E. Ash

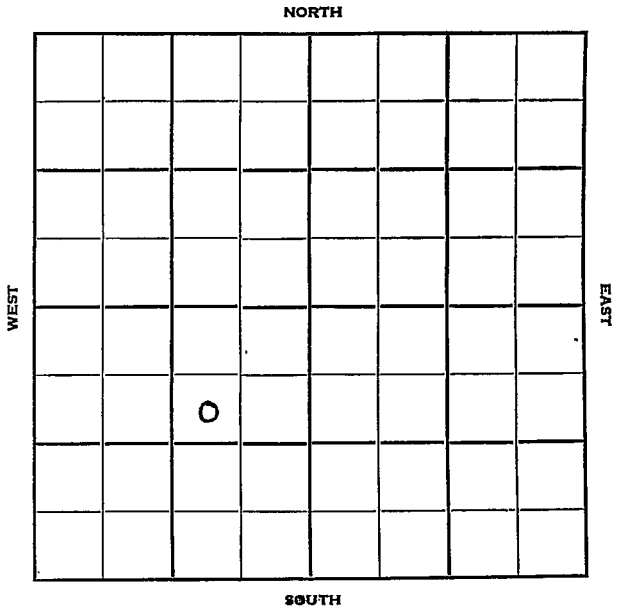

FORM 252-B
10M 10-50 PETROL

Barton

KANSAS

Sec. 10 Twp. 19 R. 11W

Well No. #7 Musenberg "D" Farm

C. E. Ash Company

Ash Contractor

Barnard Pool


990 Ft. from N. Line

Ft. from S. Line

990 Ft. from E. Line

Ft. from W. Line

SW NE SW

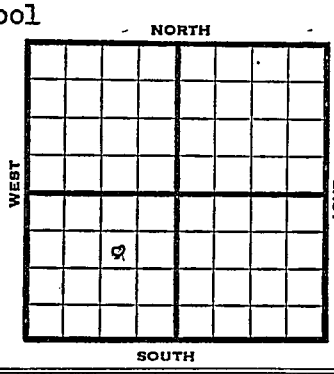

1952	REPORT
2/20	RUR
3/5	Topeka 2641 Heeb.2911 Dodge 2932 Br Li 3030 Lans. 3050 DST 3184-96 20 mins 11'mud 800# DST 3217-27 16 hr. 15'mud Cong sd 3330 Cherty Cong 3352 Arb. 3362 3380 RTB 5"@ 3262 WOC
3/11	NR
3/19	"
3/25	CO
4/1	CO to 3243' 12/3221-25 1000 A 2½ BFPH 50% wtr. Set plug 3210' 18/3187-93 1000 A 1½ BFPH 50% wtr. Set plug 2890' 23/2860-68 1000 A 6 BOPH to Sq. perfs.
4/9	Spud 2-20-52 D & A TD 3380' 8" @ 327 Top. 2641' Heeb 2911' Dodge 2932 Br. lime 3030' Lans. 3050' DST 3184-96 open 20 min, rec 11' mud DST 3217-27 open ½ hr. rec 15' mud Cong. 3330' Cherty Cong. 3352' Arb. 3362' TD 3380' 5" @ 3262'

OVER

1952
4/9

(Information continued)
CO to 3243' 12/3221-25 1000 A
2½ BFPH 50% water SP 3210'
18/3187-93 1000 A 1½ BFPH
50% water. SP 2890 23/2860-68
1000 A 6 BWPH Test 12 BWPH
D & A

ABANDONED

FORM 275 FOR SALE BY KANSAS BLUE PRINT CO.


County Barton State Kansas

Sec. 10 (Blk. Twp.) 19 (Sur. Rge.) 11W Map No.

Operator C. E. Ash

Well No. 7 Farm Musenberg "D"

Elev. Location SW NE SW

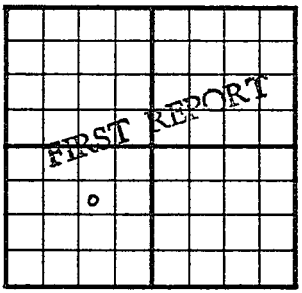

990 Ft. From N Line SW

990 Ft. From E Line Quarter

1st. Report FEB 20 1952

Completion

Remarks

Ash - Contr.

Spudding Date

Drlg. Data Barnard Pool

R U R

J. G. McGEHEE

Scout Cards .....
Land Small Map .....
Land Wall Map .....
Tracings .....
France Map .....
Pierce Map .....
Misc. .....

FEB 25 1952

Drlg. Data

FORM 275 FOR SALE BY KANSAS BLUE PRINT CO.


County Barton State Kansas

Sec. 10 (Blk. Twp.) 19 (Sur. Rge.) 11W Map No.

Operator C. E. Ash

Well No. 7 Farm Musenberg "D"

Elev. 1772 Location SW NE SW

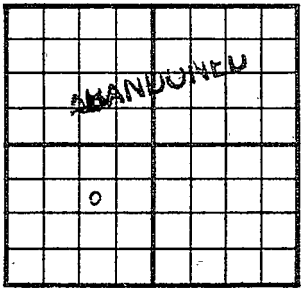

990 Ft. From N Line SW

990 Ft. From E Line Quarter

1st. Report

Completion APR 9 1952

Remarks Barnard Pool

Ash - Contr.

Spudding Date 2-20-52

Drlg. Data D & A TD 3380

8" @ 327 Top. 2641 Heeb. 2911

Dodge 2932 Br. lime 3030 Lans. 3050

DST 3184-96 open 20 min. Rec. 11' mud

DST 3217-27 open ½ hr. Rec. 15' mud

Cong. 3330 Cherty Cong. 3352 Arb. 3362

TD 3380 5" @ 3262 CO to 3243 12/ 3221-25 1000 A 2½ bfph 50% water SB 3210

18/ 3187-93 1000 A 1½ bfph 50% water SP 2890 23/ 2860-68 1000 A 6 bwph test 12 bwph

D & A

J. G. McGEHEE

Punch Cards	
Hand Small Map	
Hand Wall Map	
[illegible]	
[illegible]	
Misc.	

APR 16 1952

Drlg. Data