

Barton


KANSAS

Section 10 Township 19 Range 11WWell No. 8 Musenbërg "D"Company C.E. Ash etal

NORTH

WEST

EAST

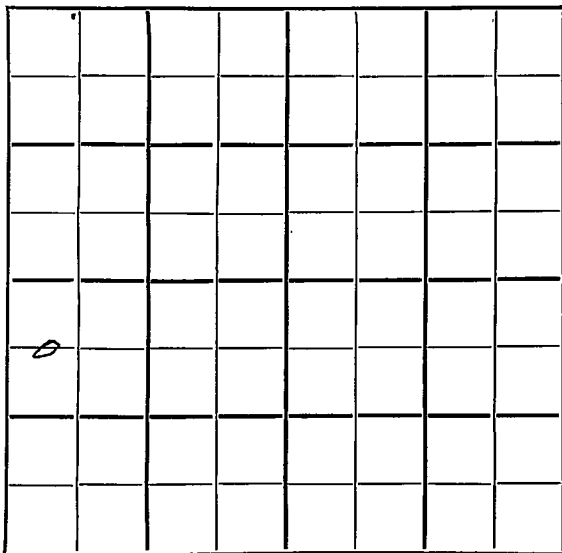

SOUTH

Barton KANSAS


Sec. 10 Twp. 19 R. 11 WWell No. # 8 Musenberg "D" FarmC. E. Ash et al CompanyAsh Contractor660 Ft. from N. Line

Ft. from S. Line

Ft. from E. Line

300 Ft. from W. Line.

C W L NW SW

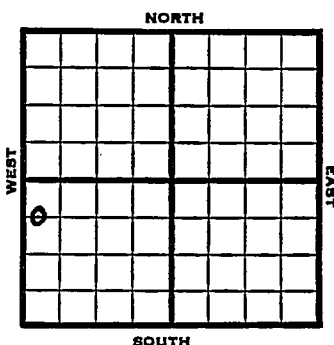

1952 Elev. 1764' REPORT

12/30 Spud 12-28-52
8" @ 205' WOC

1/1 WOC

1/8 Top 2638 Heeb 2905 Tor 2926
Br 1 3021 Ø3179

1/14 Spud 12-28-52
D&A TD 3344
8" @ 205'
Top 2638, Heeb 2905, Tor 2926,
Br. lime 3021
DST 2841-61, opn 1 hr., rec.
40' o & wcm 490#
Lans 3040
DST 3119-31, opn 1 hr., rec.
90' mud & wtr 0#
DST 3173-87, opn 1 hr., rec.
30' gcm, 120' gas & SSO 90#
DST 3207-19, opn 1-hr., rec.
45' mud, 560#
Cong 3320
TD 3344
D&A

ABANDONED

County Barton State KansasSec. 10 (Blk. Twp.) 19 (Sur. Rge.) 11W Map No.Operator C. E. Ash et al.Well No. 8 Farm Musenberg "D"Elev. - Location C W L NW SW

FIRST REPORT


660 Ft. From N Line SW300 Ft. From W Line Quarter1st. Report DEC 30 1952Completion Remarks Ash - Contr.Spudding Date 12-28-52Drig. Data 8" @ 205 WOG

Scout Cards	mm
Land Small Map	
Land Wall Map	3
Tracings	
France Map	
Pierce Map	
Misc.	

JAN 2 1952

Drig. Data

County Barton State Kansas
 Sec. 10 (Blk. 19 (Sur. 11W Map No.
 (Twp. (Rge.)
 Operator C. E. Ash et al.
 Well No. 8 Farm Musenberg "D"
 Elev. 1764 Location C W L NW SW

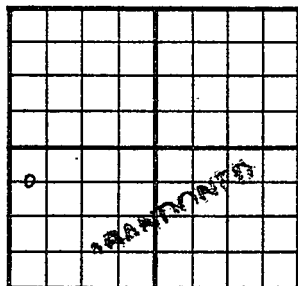660 Ft. From N Line SW300 Ft. From W Line Quarter

1st. Report

Completion IAN 14 1953

Remarks

Ash - Contr.Spudding Date 12-28-52Drig. Data D & A TD 33448" @ 205 Top. 2638 Heeb. 2905Tor. 2926 Br. line 3021 DST 2841-61open 1 hr. Rec. 40' o & wcm 490#Lans. 3040 DST 3119-31 open 1 hr.Rec. 90' mud & wtr. 0# DST 3173-87open 1 hr. Rec. 30' gcm 120' gas & SSO90# DST 3207-19 open 1 hr. Rec. 45'mud 560# Cong. 3320 TD 3344D & A

J. G. McGEHEE

Scout Cards

Land Small Map

Land Wall Map

Tracings

France Map

Pierce Map

Misc.

JAN 23 1953

Drig. Data