
FORM 51 25M 8-50 WESTERN Barton KANSAS

Section 10 Township 19 Range 11W

Well No. #1 Musenberg "E"

Company C. E. Ash

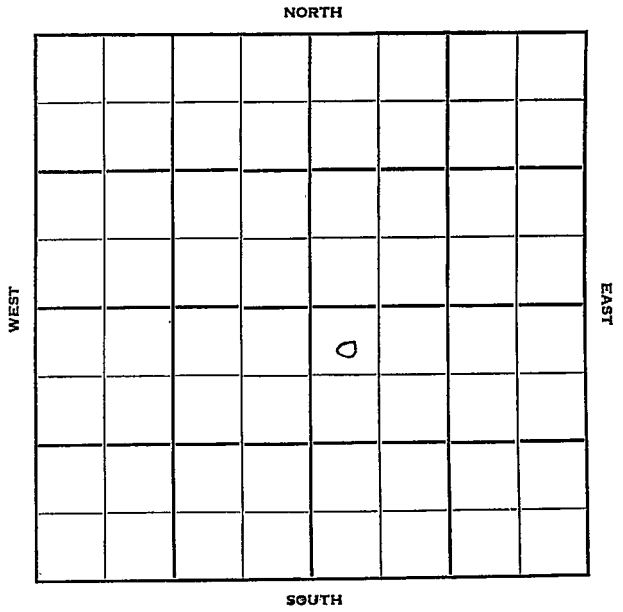

FORM 252-B
10M 8-51 TPCO. Barton KANSAS

Sec. 10 Twp. 19 R. 11W

Well No. #1 Musenberg "E" Farm

C. E. Ash Company

Contractor


330 Ft. from N. Line

Ft. from S. Line

Ft. from E. Line

330 Ft. from W. Line

NW NW SE

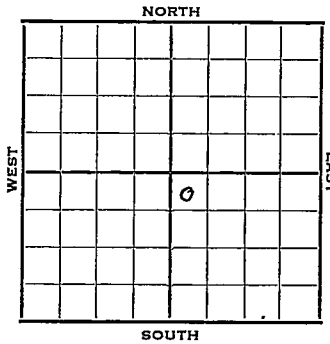

1952 Elev. 1766' REPORT

5/14 Location

5/21 8" @ 327' Anhy 555' Drlg. 2195'

5/28 RTD 3348' 5" @ 3287' WOC

6/11 MIST

6/18 NR

6/25 "

7/2 Spud 5-15-52
D&A TD 3348 8"@ 327
Anhy 555 DST 2849-65 open 3/4 hr.
Rec. 60' watery mud
Heeb. 2908 Br Li 3027
Lans. 3047
DST 3123-35 open 3/4 hr. rec. 360' gas
60' O&GCM 60' O&GCMSW
DST 3180-3190 open 3/4 hr. rec. 660'
gas 30' SOCM
DST 3210-20 open 50 min. rec. 30' socm
120' gas Cong. 3335 Ch Cong. 3340
TD 3348 5" @ 3287 CO to 3348
21/ 3179-83 4000 A S/ 2 boph 50% wtr.
D&A

ABANDONED

FORM 275 FOR SALE BY KANSAS BLUE PRINT CO.


County Barton State Kansas

Sec. 10 (Blk. Twp.) 19 (Sur. Rge.) 11W Map No.

Operator C. E. Ash

Well No. 1 Farm Musenberg "E"

Elev. Location NW NW SE

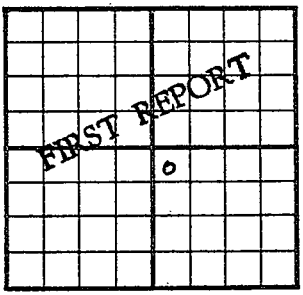

330 Ft. From N Line SE

330 Ft. From W Line Quarter

1st. Report MAY 14 1952

Completion

Remarks

Spudding Date

Drlg. Data

Location

J. G. McGEHEE

Scout Cards .....
Land Small Map .....
Land Wall Map .....
Tracings .....
France Map .....
Pierce Map .....
Misc. .....

MAY 16 1952

Drlg. Data

FORM 275 FOR SALE BY KANSAS BLUE PRINT CO.


County Barton State Kansas

Sec. 10 (Blk. Twp.) 19 (Sur. Rge.) 11W Map No.

Operator C. E. Ash

Well No. 1 Farm Musenberg "E"

Elev. 1766 Location NW NW SE

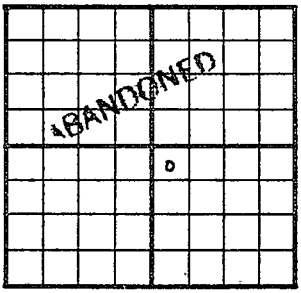

330 Ft. From N Line SE

330 Ft. From W Line Quarter

1st. Report

Completion JUL 2 1952

Remarks

Spudding Date 5-15-52

Drlg. Data D & A TD 3348

8" @ 327 Anhy 555 DST 2849-65

open 3/4 hr. Rec. 60' watery mud

Heeb. 2908 Br. lime 3027 Lans. 3047

DST 3123-35 open 3/4 hr. Rec. 360' gas

60' o & gcm 60' o & gcmsw DST 3180-3190

open 3/4 hr. Rec. 660' gas 30' socm

DST 3210-20 open 50 min. Rec. 30' socm

120' gas Cong. 3335 Ch. Cong. 3340

TD 3348 5" @ 3287 CO to 3348

21/ 3179-83 4000 A S/ 2 boph 50% water

D & A

J. G. McGEHEE

Scout Cards
Land Small Map
Land Wall Map 59
Tracings
France Map
Pierce Map
Misc.

JUL 9 1952

Drlg. Data