


Section 10 Township 19 Range 11W

Well No. #2 Musenberg "E"

Company C. E. Ash

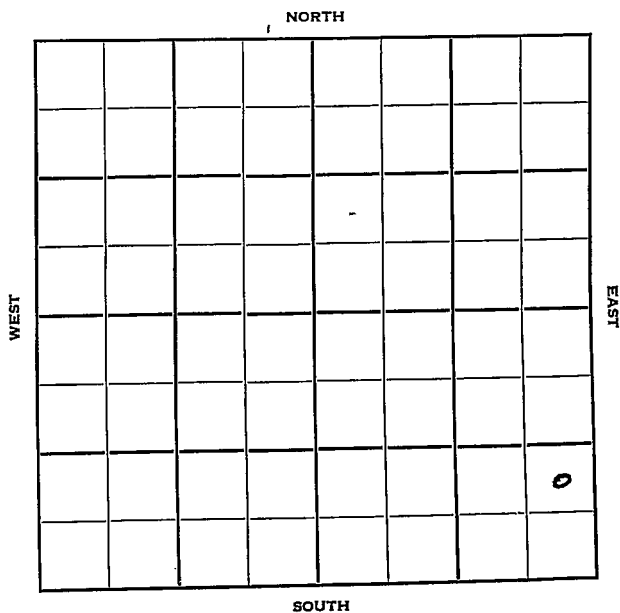

Barton

KANSAS

Sec. 10 Twp. 19 R. 11W

Well No. #2 Musenberg "E" Farm

C. E. Ash Company

Ash Contractor


Ft. from N. Line

990 Ft. from S. Line

330 Ft. from E. Line

Ft. from W. Line

NE SE SE

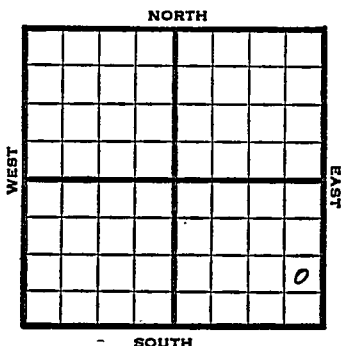

1952

Lev. 1771: REPORT

10/1

Spud 9-24-52

8" @ 203 Anhy 555 Top. 2642

Drlg. 2848

10/8

Heeb. 2901

Dodge 2921

Br Li 3020

Lans. 3040

DST 3124-34 open $\frac{1}{2}$ hr. rec. 15' mud

DST 3173-93 open 1 hr. rec. 1080' gas

45' O&GCM

DST 3211-23 open $\frac{1}{2}$ hr. rec. 6' mud

& SSO

Cong. 3318

Ch Cong. 3333

Arb. 3338-72 TD

5" @ 3235'

10/15

"

10/22

NR

10/29

CO 24/3182-90 1000A, S/1 BFPH 50% wtr

PB 3100 12/3074-76 1000A

11/5

12/3074-76 1000A

11/12

4 to 5 BOPD

11/20

NR

11/27

"

OVER

1952

12/3 Spud 9-24-52

D&A

TD 3372

8" @ 203

Anhy 555, Top 2642, Heeb.

2901, Dodge 2921, Br. Lime

3020, Lans 3040

DST 3124-34, opn $\frac{1}{2}$ hrs., rec.
15' mud

DST 3173-93, opn 1 hr., rec.
1080' gas, 45' o & g cm

DST 3211-23, opn $\frac{1}{2}$ hrs., rec.
6' mud & SSO shy Cong. 3318'

Ch. Cong. 3333, Arb. 3338

TD 3372,

5" @ 3235, 24/3182-90, 1000A

S/1 bfph 50% wtr., PB 3100

12/3074-76, 1000A, 4 to 5 bopd

D&A

ABANDONED

County **Barton** State **Kansas**

Sec. 10 (Blk. Twp.) 19 (Sur. Rge.) 11W Map No.

Operator C. E. Ash

Well No. **2** Farm **Musenberg "E"**

Elev.	Location	NE	SE	SE
-------	----------	----	----	----

FIRST REPORT

990 Ft. From S Line SE

330 Ft. From E Line Quarter

1st. Report OCT 1 1952

Completion

Remarks

Ash - Contr.

Spudding Date 9-24-52

Drbg. Data


8th @ 203 Anhy' 555 Top. 2642

drlg. 2848

J. G. McGEHEE

Scout Cards	
Land Small Map	
Land Wall Map	
Teachings	
France Map	
Large Map	
Misc	

OCT 3 1952

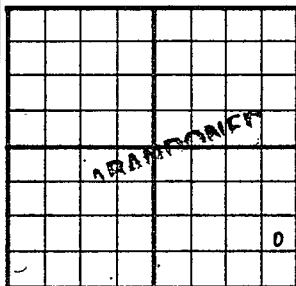County Barton State KansasSec. 10- (Blk.
Twp.) 19 (Sur.
Rge.) 11W Map No.Operator C. E. AshWell No. 2 Farm Musenberg "E"Elev. 1771 Location NE SE SE990 Ft. From S Line SE330 Ft. From E Line Quarter

1st. Report

Completion DEC 3 1957

Remarks

Ash - Contr.Spudding Date 9-24-52Drlg. Data D & A TD 33728" @ 203 Anhy 555 Top. 2642Heeb. 2901 Dodge 2921 Br. lime 3020Lans. 3040 DST 3124-34 open $\frac{1}{2}$ hr.Rec. 15' mud DST 3173-93 open 1 hr.Rec. 1080' gas 45' o & gcm DST 3211-23open $\frac{1}{2}$ hr. Rec. 6' mud & SS0 shy. cong.3318. Ch. Cong. 3333 Arb. 3338TD 3372 5" @ 3235 24/ 3182-90 1000 AS/ 1 bfph 50% wtr. PB 310012/ 3074-76 1000 A 4 to 5 bopdD & A

Scout Cards	_____
Land Small Map	_____
Land Wall Map	_____
Tracings	_____
France Map	_____
Pierce Map	_____
Misc.	_____

W

DEC 10 1952

23