

Section

10

Township

19

Range


10 W

Well No.

1 Benhke

Company

G.M.R.

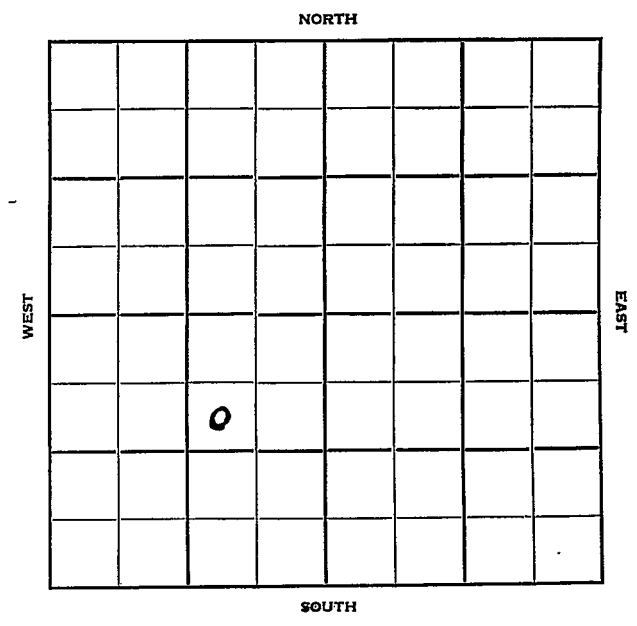

Rice

KANSAS

Sec. 10 Twp. 19 R. 10 W

Well No. #1 Benhke Farm

G. M. R. Company

Greeley Contractor

Semi-wildcat


990 Ft. from N. Line

Ft. from S. Line

990 Ft. from E. Line

Ft. from W. Line

SW NE SW

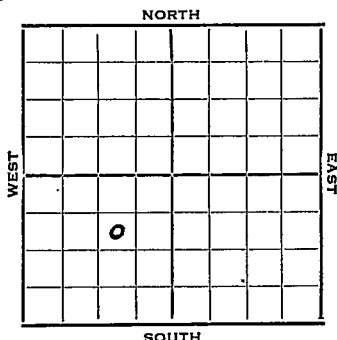

1952

Elev. 1761' REPORT

4/2

Spud 3-29-52
8" @ 168'
Anhy 525'
Drlg. 867'


4/9

Heeb. 2834 Br Li 2992
Lans. 2990
DST 2990-3027 1 hr. 50 M O#
DST 3060-73 3/4 hr. 240' O&GCM
40' SW 720' gas Drlg. 3158

4/16

Spud 3-29-52
D&A TD 3365 8" @ 168
Anhy 525 Heeb. 2834
Br Li 2927 Lans. 2990
DST 2990-3027 open 1 hr. rec. 50'
mud
DST 3060-73 open 3/4 hr. rec. 240'
O&GCM 10' SW 720' gas
Cong. 3294
DST 3284-3329 open 45 min. rec. 8' mud
Arb. 3332 DST 3333-38 open 45 min.
Rec. 25' mud TD 3365
D&A

ABANDONED

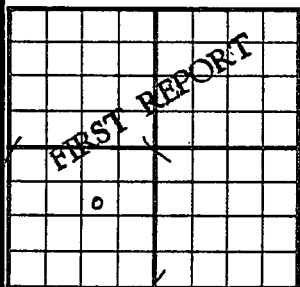County Rice State KansasSec. 10 (Blk.) 19 (Sur.) 10W Map No.Operator G. M. R.Well No. 1 Farm BenhkeElev. Location SW NE SW990 Ft. From N Line SW990 Ft. From E Line Quarter1st. Report APR 2 1952

Completion

Remarks

Greeley - Contr.Spudding Date 3-29-52Drilg. Data Semi wildcat8" @ 168 Anhy 525 Drilg. 867


J. G. McGEHEE

County Rice State Kansas
 Sec. 10 (Blk. 19 (Sur. 10W Map No.)
 (Twp.) (Rge.)

Operator G-M-R Oil

Well No. 1 Farm Behnke

Elev. 1761 Location SW NE SW

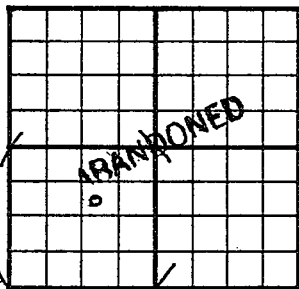

990 Ft. From N Line SW

990 Ft. From E Line Quarter

1st. Report

Completion APR 16 1952

Remarks Semi Wildcat

Greeley Drlg. - Contr.

Spudding Date 3-29-52

Drlg. Data D & A TD 3365

8" @ 168 Anhy 525 Heeb. 2834

Br. lime 2972 Lans. 2990 DST 2990-3027

open 1 hr. Rec. 50' mud DST 3060-73

open 3/4 hr. Rec. 240' o & gcm 40' sw

720' gas Cong. 3294 DST 3284-3329

open 45 min. Rec. 8' mud Arb. 3332

DST 3333-38 open 45 min. Rec. 25' mud

TD 3365

D & A

J. G. McGEHEE